

CALHOUN MISSISSIPPI BOARD OF WATER COMMISSIONERS

H4
3-62

WATER WELL DRILLERS LOG

CALHOUN

Date: MARCH, 1962, Driller: Sam Smith County Calhoun
(Name)

(1) Owner of Land: R. B. Massey
(Name)
Vardaman, Miss.
(Address)

(2) Location: 36 135 E
E miles Northeast of Vardaman
(distance) (direction) (Nearest Town)

(3) Topography: r
(Hilly) (Flat) (Level)

(4) Purpose of Well: Domestic
(Domestic Irrigation
Municipal, Industrial, Other)

Description & Color of Materials Sand, Clay, Red Clay, Shell, etc.	Thick- ness Feet	Depth Feet
Clay	0	20
Limestone clay	20	60
Limestone stream	60	70
Shale	70	180
Blue Gumbo	180	300
Gumbo shale	300	525
Wick of sand	525	560
Gumbo shale	560	700
White Chalk	700	1000
Black shale	1000	1125
Utah sand	1125	1260

Information upon completion of well:

(1) Diameter 4 inches.

(2) Total Depth 1260 feet.

(3) Water Level 200 feet below top of ground.

(4) Cased to 210, Size 4"

(5) Screen: Size _____, Length _____


(6) Were any formations sealed against pollution?
r yes, _____ no.

If YES, depth of formation 60 feet

Why Surface + lime water

Drillers Remarks: _____

Return to
but coded
needed

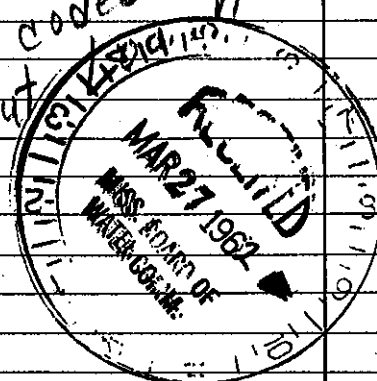

(Use Back Side)

Well No. _____