

CALHOUN

MISSISSIPPI BOARD OF WATER COMMISSIONERS

CODED

H 300

H 7

5-16-61

WATER WELL DRILLERS LOG

Calhoun

Date: 5-16, 1961, Driller: R. B. Ashby, County: Calhoun

(Name)

(1) Owner of Land: <u>Henry E. Bailey</u> (Name)	Description & Color of Materials Sand, Clay, Red Clay, Shell, etc.	Thick- ness Feet	Depth Feet
<u>R. F. D. Vardaman Miss</u> (Address)	<u>joint clay</u>	<u>20</u>	<u>20</u>
(2) Location: <u>1/4, 1/4, Sec. 15 T13R1E,</u>	<u>black sand Rock.</u>	<u>20"</u>	<u>21</u>
<u>6 miles north</u> of <u>Vardaman</u> (distance) (direction) (Nearest Town)	<u>Black shale joint</u>		
(3) Topography: <input checked="" type="checkbox"/> (Hilly) <input type="checkbox"/> (Flat) <input type="checkbox"/> (Level)	<u>16-21' pipe</u>		
(4) Purpose of Well: <input checked="" type="checkbox"/> (Domestic Irrigation) <input type="checkbox"/> (Municipal, Industrial, Other)	<u>down to 336'</u>	<u>336'</u>	<u>356</u>
	<u>Blue Rock.</u>	<u>169'</u>	<u>525</u>
	<u>White sand, coarse no</u>		
	<u>Water</u>	<u>75'</u>	<u>600</u>
	<u>from 100' to</u>		
	<u>1145' blue Rock.</u>	<u>545'</u>	<u>1145'</u>

Information upon completion of well:


- (1) Diameter 4 inches.
- (2) Total Depth 1292 feet.
- (3) Water Level 126 feet below top of ground.
- (4) Cased to 640', Size 4"
- (5) Screen: Size 2" pipe, Length 672'
from bit up
- (6) Were any formations sealed against pollution?
 yes, no.

If YES depth of formation 35'

Why Mineral Water

Drillers Remarks:

CODED

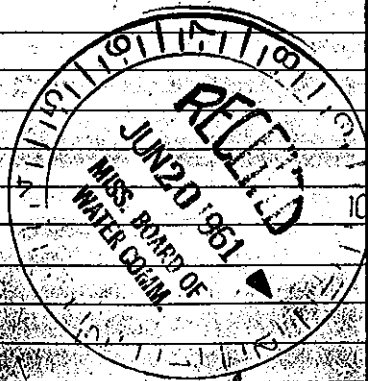

(Use Back Side)