

Calhoun
 JI
 1-67
 Elec Log

05378

Coded

MISSISSIPPI
 BOARD OF WATER COMMISSIONERS
 416 North State Street
 Jackson, Mississippi 39201

CODED
 CODED

WATER WELL DRILLERS LOG

Jan. 1967 19 Robert E. Latuff Calhoun
 date well completed firm name county well located

LANDOWNER: Big Creek
Water Assn.
Big Creek, Miss.
 (mailing address)

WELL LOCATION:
 sec 13 R. 2 8 E
23 N of Big Creek
 (distance) (direction) (nearest town)

WELL PURPOSE:
 (home, irrigation, municipal, industrial)

WELL COMPLETION DATA:

(1) diameter (inches) 10x6

(2) total depth (feet) 2412

(3) static water level (feet) 60 below top of ground.

(4) casing St 2370 ^{2366'}
 (material) (depth)

10x6 If telescope see back.
 (size) ^{2366'}

(5) screen 40' 2370
 (length) (depth to top)

.020 S.S.
 (size) (material)

(6) pump 15 150
 (HP) (yield gpm)


submersible (type power) (USGS)

(7) electric log yes (E-log # 30)
 (year or no)

U.S.G.S.
 (organization running log)

(8) how well bottom plugged B.P.U.

description of formations encountered	from	to
Red Clay	0	18
sand	18	23
Blue Clay	23	146
sand	146	156
Blue Shale	156	296
Hard Blue Shale	296	312
Rock	312	313
Shale	313	570
Shale w/ sand streaks	570	630
Hard Blue Shale	630	715
Shale	715	771
Hard Shale	771	792
Blue shale	792	835
Shale w/ sand streaks	835	891
Hard Blue Shale	891	902
Shale	902	1069
Shale + Rock	1069	1100
Shale	1100	1602
Sandy shale ^{EUTAW}	1602	1785
Shale	1785	1845
Sandy shale	1845	1926
Sand + Gravel ^{MCSHAW}	1926	1946
Clay ^{GORDO}	1946	1968
Sand + Clay	1968	1998
Sand + Gravel	1998	2018
Shale w/ sand streaks	2018	2049
Sand streaks w/ rocks	2049	2079
Shale, sand, gravel	2079	2119
Gravel	2119	2211
Shale ^{COKER}	2211	2269
Hard Shale	2269	2359
Sand + small gravel	2359	2409
Hard Shale	2409	2412

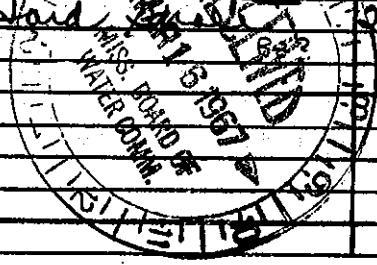

DRILLERS REMARKS: