

coded.

CODED

CODED

MISSISSIPPI
BOARD OF WATER COMMISSIONERS
416 North State Street
Jackson, Mississippi 39201

WATER WELL DRILLERS LOG

Calhoun

T 2

10-67

Elec Log

OCT. 9, 1967

DELTA DRILLING Co.

CALHOUN

date well completed

firm name

county well located

LANDOWNER: C. G. STEELE

P.O. Box 472

GREENWOOD, MISS
(mailing address)

WELL LOCATION: NW 1/4 NE 1/4

sec. 20 T23 N

R. 8E

3 miles W

(direction)

of Big Creek

(distance)

(direction)

(nearest town)


WELL PURPOSE: DOMESTIC
(home, irrigation, municipal, industrial)

WELL COMPLETION DATA:

- (1) diameter (inches) 4
- (2) total depth (feet) 416
- (3) static water level (feet) 42 below
top of ground.
- (4) casing STEEL, 2'36"
(material) (depth)
4+2 (size) if telescope see back.
- (5) screen 10' 236'
(length) (depth to top)
1 1/4" S-STEEL
(size) (material)
- (6) pump 3/4
(HP) (yield gpm)
ELEC
(type power)
- (7) electric log YES (USGS #35)
(yes or no)
MISS GEO. SURVEY
(organization running log)
- (8) how well bottom plugged BACK
PRESSURE VALVE

description of formations encountered	from to	
sand	0	23
gumbo	23	100
sand	100	138
gumbo	138	180
Shale	180	190
sand	190	204
gumbo	204	210
sand	210	246
Shale	246	291
sand	291	311
gumbo	311	416

Probably screened
246 - 256 - m63

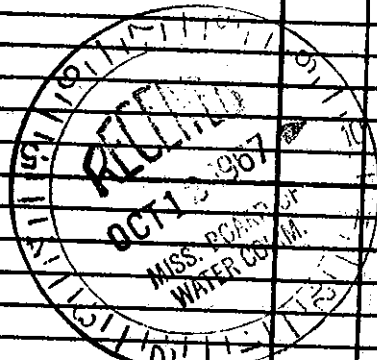

DRILLERS REMARKS: WELL SET
246' - PUMP SETTING
84' -