

CALHOUN MISSISSIPPI BOARD OF WATER COMMISSIONERS

J3
2-3-62

WATER WELL DRILLERS LOG

OK
W. S. Calhoun

Date: Feb. 3, 1962 Driller: Robert E. Pate County: Calhoun

(1) Owner of Land: <u>Mr. Harrison</u> (Name)	Description & Color of Materials Sand, Clay, Red Clay, Shell, etc.	Thick- ness Feet	Depth Feet
<u>Big Creek Miss.</u> (Address)	Clay	17	17
Location: <u>22 23N 8E</u> 1/4, 1/4, Sec. T. R.	Sand	3	22
<u>1 1/2 miles SW</u> of <u>Big Creek</u> (distance) (direction) (Nearest Town)	Clay	2	24
Topography: <u>Flat</u> (Hilly) (Flat) (Level)	Sand	8	30
Purpose of Well: <u>Domestic</u> (Domestic Irrigation Municipal, Industrial, Other)	Clay	47	77
	Sand	8	85
	Sandy Sand	35	120
	Sand	48	168

Information upon completion of well:


- (1) Diameter 2 inches.
- (2) Total Depth 168 feet.
- (3) Water Level 80 feet below top of ground.
- (4) Cased to 162', Size 2"
- (5) Screen: Size 2", Length 5
- (6) Were any formations sealed against pollution?
X yes, no.

If YES depth of formation about 15'

Why _____

Drillers Remarks: _____

Return to BOWC
Insufficient info to locate.
Coded but Loc. Needed

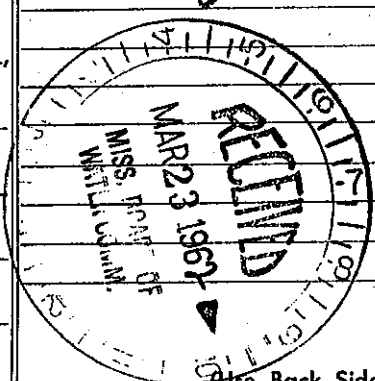

Well No. _____