

CALHOUN MISSISSIPPI BOARD OF WATER COMMISSIONERS

K 9


WATER WELL DRILLERS LOG

7-31-64

CALHOUN

Date: July 31, 1964, Driller: Robert F. Rathoff County Monroe
(Name)

(1) Owner of Land:	Description & Color of Materials Sand, Clay, Red Clay, Shell, etc.	Thick- ness Feet	Depth Feet
<u>Don Amos</u> <small>(Name)</small> <u>Calhoun City, Miss</u> <small>(Address)</small> <u>1923 N 7th</u>	<u>Clay</u>	<u>0</u>	<u>17</u>
(2) Location: <u>1/4</u> , <u>1/4</u> , Sec. <u>T</u> , <u>R</u>	<u>Loam</u>	<u>17</u>	<u>23</u>
<u>4</u> miles <u>West</u> of <u>Calhoun City</u> <small>(distance) (direction) (Nearest Town)</small>	<u>Clay & Rock</u>	<u>93</u>	<u>45</u>
(3) Topography: <u>Hilly</u> <small>(Hilly) (Flat) (Level)</small>	<u>White Sand</u>	<u>45</u>	<u>58</u>
(4) Purpose of Well: <u>Domestic</u> <small>(Domestic Irrigation Municipal, Industrial, Other)</small>			
Information upon completion of well:			
(1) Diameter <u>4</u> inches.	Return to coded but needed Loc.		
(2) Total Depth <u>59</u> feet.			
(3) Water Level <u>2 low</u> feet below top of ground.			
(4) Cased to <u>59</u> , Size <u>4</u>			
(5) Screen: Size <u>3</u> , Length <u>4'</u>			
(6) Were any formations sealed against pollution? <u>✓</u> yes, <u>no.</u>			
If YES depth of formation <u>Cased</u>			
Why _____			
Drillers Remarks: _____			

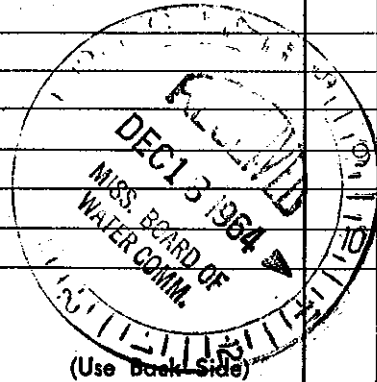

Well No.

Mail this copy to Board of Water Commissioners 429 Miss. St. Jackson, Miss.