

`		· · · · · · · · · · · · · · · · · · ·
County: CALHOUN	Part 1 – Driller's Log	For Office Use Only
County: <u>C4LHow</u> Permit #: MS GW 16168	Mississippi Department of Environmental Quality Office of Land and Water Resources	Aquifer:
Driller: DAPUS LOADK CLART	P.O. Box 10631	Well #: K- 103
Dind. PITCH V PITCH WICh	P.O. Box 10631 Jackson, MS 39289-0631 (601)961-5210 (601)354-6938 (fax)	L. S. Elevation:
	(601)354-6938 (fax)	E-log #:
State Law requires that this rep	oort be prepared by the license holder responsible for	the work and filed with th
Department at the above addre	ess within 30 days of completion of drilling of the wel	l or borehole.
Information on Wel (<i>Landowner if borehole is no</i> t	t for a water well)	orehole Location
Owner Name TOWN OF TO	Latitude: <u>33 ° 57 ' 95</u>	_" Longitude: <u>%9°/6</u>
• •	Method of Lat/Long (circle o	
Mailing Address: <u>Po Box 9</u>		GPS Survey-grade GPS
<u> </u>	¼¼ Sec_/5	
<u>A RAMA ME</u> City S	tate Zip Code Distance Direction	
Telephone No. $(\frac{bb2}{b2})$ $b28-b$	(Miles /	of DEAMA
Telephone No. (LOK) DRO CA		
<i>/</i> .	Well / Borehole Data	
Date drilling started: 5/2/2005 Date of	drilling completed: <u>///10/2005</u> Hole depth: <u>966</u>	Hole diameter: 7 1
	, ,	
/		
/	ater used for drilling: <u>Town of DekmA</u> ine used in drilling and development: <u>S RPM</u>	
Location of the source of any surface was Method of dosing and volume of Chlori		
Location of the source of any surface was Method of dosing and volume of Chlori Logs run (circle all applicable): No log r Name of organization running log(s):	ater used for drilling: <u>Town</u> of DekmA- ine used in drilling and development: <u>SPM</u> ,	Other:
Location of the source of any surface was Method of dosing and volume of Chlori Logs run (circle all applicable): No log r Name of organization running log(s): Purpose of borehole (check one): Water ' Seismid	ater used for drilling: <u>Town</u> of <u>Dec. mA</u> ine used in drilling and development: <u>5 <u>J.P.M.</u></u> run <u>Electric</u> <u>Gamma Ray</u> Density Sonic Neutron Well <u>Geotechnical/Geological Investigation</u> Ground c Survey Other (<i>describe</i>)	Other:
Location of the source of any surface was Method of dosing and volume of Chlori Logs run (circle all applicable): No log r Name of organization running log(s): Purpose of borehole (check one): Water ' Seismid	ater used for drilling: <u>Town</u> of <u>Decembra</u> ine used in drilling and development: <u>5 <u>J</u><u>P</u><u>M</u>, run <u>Electric</u> <u>Gamma Ray</u> Density Sonic Neutron Well <u>Geotechnical/Geological Investigation</u> Ground</u>	Other:
Location of the source of any surface was Method of dosing and volume of Chlori Logs run (circle all applicable): No log r Name of organization running log(s): Purpose of borehole (check one): Water ' Seismid <u>If drilling is not relate</u>	ater used for drilling: <u>Town</u> of <u>Dec. mA</u> ine used in drilling and development: <u>5 <u>J.P.M.</u></u> run <u>Electric</u> <u>Gamma Ray</u> Density Sonic Neutron Well <u>Geotechnical/Geological Investigation</u> Ground c Survey Other (<i>describe</i>)	Other: 1 Source Heat Pump ock
Location of the source of any surface was Method of dosing and volume of Chlori Logs run (circle all applicable): No log r Name of organization running log(s): Purpose of borehole (check one): Water ' Seismic <u>If drilling is not related</u> Purpose of Well (check one): Home	ater used for drilling: <u>Town</u> of <u>Dec.mA</u> ine used in drilling and development: <u>5</u> <u><u>CPM</u>, run <u>Electric</u> <u>Gamma Ray</u> Density Sonic Neutron Well <u>Geotechnical/Geological Investigation</u> Ground c Survey Other (<i>describe</i>) <u>ed to water well construction, skip the remainder of this bl</u></u>	Other: I Source Heat Pump ock Other:
Location of the source of any surface was Method of dosing and volume of Chlori Logs run (circle all applicable): No log r Name of organization running log(s): Purpose of borehole (check one): Water ' Seismic <u>If drilling is not related</u> Purpose of Well (check one): Home If a flowing well, method of flow regulat	ater used for drilling: <u>Town</u> of <u>Dec.mA</u> ine used in drilling and development: <u>5</u> <u><u>R</u><u>P</u><u>M</u>, run <u>Electric</u> <u>Gamma Ray</u> Density Sonic Neutron Well <u>Geotechnical/Geological Investigation</u> Ground c Survey Other (<i>describe</i>) <u>ed to water well construction, skip the remainder of this bl</u> Industrial Public Supply <u>Irrigation</u> Fish Culture</u>	Other: I Source Heat Pump ock Other:
Location of the source of any surface was Method of dosing and volume of Chlori Logs run (circle all applicable): No log r Name of organization running log(s): Purpose of borehole (check one): Water V Seismic If drilling is not related Purpose of Well (check one): Home If a flowing well, method of flow regulat Static Water Level:257.535feet a	ater used for drilling: <u>Teura</u> <u>of Dec mA</u> ine used in drilling and development: <u>5 <u>R</u>PM</u> , nun <u>Electric</u> <u>Gamma Ray</u> Density Sonic Neutron Well <u>Geotechnical/Geological Investigation</u> Ground c Survey Other (<i>describe</i>) <u>ed to water well construction, skip the remainder of this bl</u> Industrial Public Supply <u>Irrigation</u> Fish Culture ion: Valve <u>Other</u> (describe) <u>Supply</u> Irrigation Date measured:	Other: I Source Heat Pump ock Other:
Location of the source of any surface was Method of dosing and volume of Chlori Logs run (circle all applicable): No log r Name of organization running log(s): Purpose of borehole (check one): Water ' Seismic <u>If drilling is not related</u> Purpose of Well (check one): Home If a flowing well, method of flow regulat Static Water Level:/25.535feet a Method of Measurement (circle one)	ater used for drilling: <u>Teura</u> <u>of Dec mA</u> ine used in drilling and development: <u>5 <u>R</u>PM</u> , nun <u>Electric</u> <u>Gamma Ray</u> Density Sonic Neutron Well <u>Geotechnical/Geological Investigation</u> Ground c Survey Other (<i>describe</i>) <u>ed to water well construction, skip the remainder of this bl</u> Industrial Public Supply <u>Irrigation</u> Fish Culture ion: Valve <u>Other</u> (describe) <u>Supply</u> Irrigation Date measured:	Other: I Source Heat Pump ock Other:
Location of the source of any surface was Method of dosing and volume of Chlori Logs run (circle all applicable): No log r Name of organization running log(s): Purpose of borehole (check one): Water V Seismic If drilling is not related Purpose of Well (check one): Home If a flowing well, method of flow regulat Static Water Level:/25.53 feet a Method of Measurement (circle one) Well depth: _/926 Well grouted to a construction Well depth: _/926 Well grouted to a construction Method of Measurement (circle one)	ater used for drilling: <u>Teura</u> <u>of Decemb</u> ine used in drilling and development: <u>5</u> <u><u>R</u><u>P</u><u>M</u>, nun Electric Gamma Ray Density Sonic Neutron Well <u>Geotechnical/Geological Investigation</u> Ground c Survey Other (<i>describe</i>) <u>ed to water well construction, skip the remainder of this bl</u> Industrial Public Supply <u>Irrigation</u> Fish Culture ion: Valve <u>Other (describe)</u> above or below (circle one) land surface Date measured: steel tape <u>electric tape</u> air line other: <u></u></u>	Other:
Location of the source of any surface way Method of dosing and volume of Chlori Logs run (circle all applicable): No log r Name of organization running log(s): Purpose of borehole (check one): Water V Seismin If drilling is not related Purpose of Well (check one): Home If a flowing well, method of flow regulat Static Water Level: $_/25.55^{-}_{-}$ feet a Method of Measurement (circle one) Well depth: $_/926_{-}$ Well grouted to a co Casing length: $_/855^{-}_{-}$ feet Cas	ater used for drilling: <u>Teura</u> <u>of Dec mA</u> ine used in drilling and development: <u>5 <u>R</u>PM</u> , nun <u>Electric</u> <u>Gamma Ray</u> Density Sonic Neutron Well <u>Geotechnical/Geological Investigation</u> Ground c Survey Other (<i>describe</i>) <u>ed to water well construction, skip the remainder of this bl</u> Industrial Public Supply <u>Irrigation</u> Fish Culture ion: Valve <u>Other</u> (describe) above or below (circle one) land surface Date measured: steel tape <u>electric</u> tape air line other: <u></u> depth of <u>1835</u> feet Type of grout (circle one): Neat Cerri	Other: I Source Heat Pump ock Other: Other: ent Bentonite Mix STrés L
Location of the source of any surface way Method of dosing and volume of Chlori Logs run (circle all applicable): No log r Name of organization running log(s): Purpose of borehole (check one): Water V Seismin If drilling is not related Purpose of Well (check one): Home If a flowing well, method of flow regulat Static Water Level: $_/25.55^{-}$ feet a Method of Measurement (circle one) Well depth: $_/926^{-}$ Well grouted to a co Casing length: $_/855^{-}$ feet Case Screen length: $_/260^{-}$ feet Screen	ater used for drilling: <u>Teura</u> <u>of Dec.mA</u> ine used in drilling and development: <u>5 //PM</u> , nun Electric Gamma Ray Density Sonic Neutron WellGeotechnical/Geological InvestigationGround c SurveyOther (<i>describe</i>) <u>ed to water well construction, skip the remainder of this bl</u> IndustrialPublic Supply /_IrrigationFish Culture ion: ValveOther (describe) above or below (circle one) land surface bate measured: steel tape air line other: depth of /825 feet Type of grout (circle one): Neat Cem sing diameter: Z inches Type of casing:	Other: I Source Heat Pump ock Other: Other: Other: Bentonite Mix STRick L STRINKESS
Location of the source of any surface way Method of dosing and volume of Chlori Logs run (circle all applicable): No log r Name of organization running log(s): Purpose of borehole (check one): Water V Seismin If drilling is not related Purpose of Well (check one): Home If a flowing well, method of flow regulat Static Water Level: $/25.53^{-}$ feet a Method of Measurement (circle one) Well depth: $/926$ Well grouted to a c Casing length: $/853^{-}$ feet Cas Screen length: $/20^{-}$ feet Scr Screen slot size:030inches	ater used for drilling: <u>Teura</u> <u>of Decemb</u> ine used in drilling and development: <u>5</u> <u><u><u>R</u><u>P</u><u>M</u></u>, nun <u>Electric</u> <u>Gamma Ray</u> Density Sonic Neutron Well <u>Geotechnical/Geological Investigation</u> Ground c Survey <u>Other (describe)</u> <u>ed to water well construction, skip the remainder of this bl</u> <u>Industrial</u> <u>Public Supply</u> <u>Irrigation</u> <u>Fish Culture</u> ion: Valve <u>Other (describe)</u> above or below (circle one) land surface Date measured: steel tape <u>etectric tape</u> air line other: <u></u> steel tape <u>etectric tape</u> air line other: <u></u> sing diameter: <u>7</u><u>Z</u> inches Type of casing: <u></u> reen diameter: <u>7</u><u>86</u><u>c</u> feet to <u>7</u><u>9</u></u>	Other:
Location of the source of any surface way Method of dosing and volume of Chlori Logs run (circle all applicable): No log r Name of organization running log(s): Purpose of borehole (check one): Water V Seismin If drilling is not related Purpose of Well (check one): Home If a flowing well, method of flow regulat Static Water Level: $/25.53^{-}$ feet a Method of Measurement (circle one) Well depth: $/926$ Well grouted to a c Casing length: $/853^{-}$ feet Cas Screen length: $/20^{-}$ feet Scr Screen slot size:030inches	ater used for drilling: Teurnel Free mathematical and development: Sonic Sonic Method nun Electric Gamma Ray Density Sonic Neutron Well Geotechnical/Geological Investigation Ground c Survey Other (describe) Geotechnical/Geological Investigation Fish Culture inn: Valve Other (describe) above or below (circle one) land surface Date measured: steel tape etectric tape air line other: depth of /855 feet Type of grout (circle one): Neat Cerre Sing diameter:	Other:
Location of the source of any surface way Method of dosing and volume of Chlori Logs run (circle all applicable): No log r Name of organization running log(s): Purpose of borehole (check one): Water V Seismin If drilling is not related Purpose of Well (check one): Home If a flowing well, method of flow regulat Static Water Level: $/25.53^{-}$ feet a Method of Measurement (circle one) Well depth: $/926$ Well grouted to a c Casing length: $/853^{-}$ feet Cas Screen length: $/20^{-}$ feet Scr Screen slot size:030inches	ater used for drilling: <u>Teuro</u> <u>of Decemb</u> ine used in drilling and development: <u>5 //PM</u> , nun Electric Gamma Ray Density Sonic Neutron WellGeotechnical/Geological InvestigationGround c SurveyOther (<i>describe</i>) <u>ed to water well construction, skip the remainder of this bl</u> IndustrialPublic Supply / IrrigationFish Culture ion: ValveOther (describe) above or below (circle one) land surface Date measured: steel tape <u>etectric tape</u> air line other: depth of /855 feet Type of grout (circle one): Neat Cerr sing diameter: inches Type of screen: setting depth: From/8/6 c feet to/9): Grevel packed Underreamed Telescoped Open Other (describe):	Other:

DEC 0 6 2005 BY: OLWR

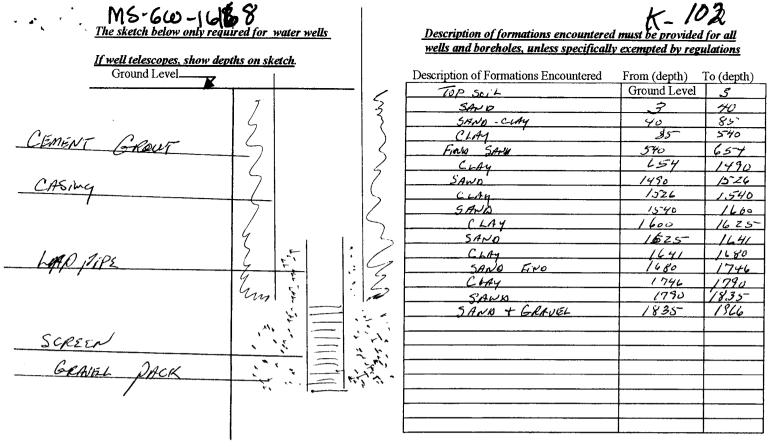

If more than one screen, show location of each on sketch

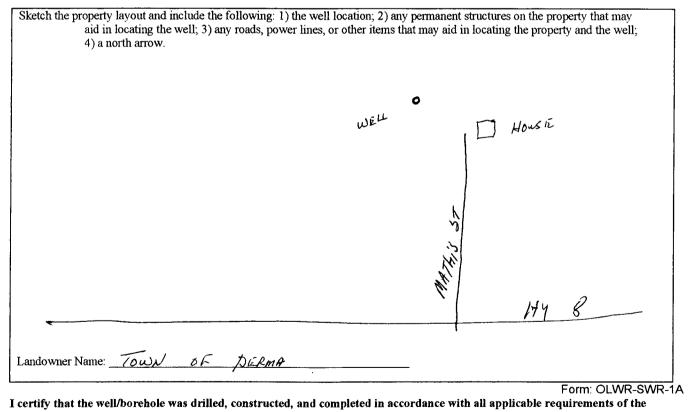

Mississippi Department of Environmental Quality and the Mississippi Department of Health regulations, if applicable, and state

laws URNIARIES

12/2/05

n 44 Signature of Licensee

Print Name of Responsible Licensee and License No.

Date

Irre of Licensee RECEIVED

DEC 0 6 2005 BY: OLWP

County: <u>CALIGOUN</u> Permit #: <u>IGIGS</u> Driller: <u>PARKS + FARKS WELL</u> SERVICE Date completed: <u>Copy information from block on Part 1</u>	Jackson, MS 39289-0631 (601)961-5210 (601)354-6938 (fax)	Quality Aquifer: Well #: K-102 Elevation:
This part of the report must be completed b report must be attached and both parts file	by a licensed water well contractor or a licens d with the Department at the above address w	sed pump installer. A copy of Part 1 of the vithin 30 days of well completion.
Well Owner Information		Well Location
Owner Name: TOWN OF DER	Latitude: 33 -52	<u>~55</u> Longitud <u>89-16-91</u>
Mailing Address: PO BOX	98 Method of Lat/Long	<u>~55</u> <u>33</u> g (check one): Conventional Survey,
		Hand-held GPS, Survey-grade GPS
Dizfina MS City State		4 Sec 15 T145 R 1 W
City State		Direction Nearest Town
Telephone No. (102) 628-663		of <u>Sekmit</u>
Pump Type Circle one		Power Type Circle one
Air Lift Jet	Submersible Diesel Engine	Gasoline Engine Natural Gas
Bucket Piston	Turbine Electric Motor	Hand Tractor PTO
Centrifugal Rotary	Flowing Well Windmill	Other (specify):
Other (specify):	Horse Power Rating	g of Motor:
Date Pump Installed: / - / 7-200	Setting Depth:	/ 90 feet
Rated Pump Capacity: <u>360</u>	Gallons Per Minute Number of Stages:	6
	Meti	hod of Measuring Water Level
Pump Test Data		Circle one
•	006 Airline Fl	Circle one
Date Well Tested: <u>3-27-2</u>	Below Land Surface Air Line Ek	ectric Measuring Line Steel Tape
Date Well Tested: $3 - 27 - 24$ Static Water Level (A): 125 Feet B	Below Land Surface Air Line Ek	
Date Well Tested: $3 - 27 - 24$ Static Water Level (A): 125^{-1} Feet B Pumping Water Level (B): 138^{-1} Feet B	Below Land Surface Air Line Ele Below Land Surface Other (specify):	ectric Measuring Line Steel Tape
Date Well Tested: $3 - 27 - 24$ Static Water Level (A): 125 Feet B	Below Land Surface Air Line Ele Colow Land Surface Below Land Surface For flowing well, m	ectric Measuring Line Steel Tape

- - - - - -

I HEREBY DERTIFY that the above statements are true to the best of	of my knowledge
NAUDURN TARKS 0-414	(Mashun tah
Print Name of Pump Installer and License No. (if applicable)	Signature of Pump Installer
	Form: OLWR-SWR-1B
	RECEIVED

APR 2 7 2006 BY: OLWR