

CALHOUN

MISSISSIPPI BOARD OF WATER COMMISSIONERS

11

Return to Bowc.

10-29-62


WATER WELL DRILLERS LOG

HERNDON WELL & SUPPLY CO.

Date: Oct. 29, 1962, Driller: P. O. BOX 42

SHANNON, MISSISSIPPI County Calhoun

(1) Owner of Land: <u>Z. K. Hoog</u> (Name)	Description & Color of Materials Sand, Clay, Red Clay, Shell, etc.	Thick- ness Feet	Depth Feet
<u>Cardinals, Miss</u> (Address)	Clay		0
(2) Location: <u>145</u> 1/4, Sec. <u>1</u> T. <u>18</u> N. R. <u>1E</u> <u>4</u> miles <u>NE</u> , of <u>Warrenton</u> (distance) (direction) (Nearest Town)	Brown rock		19
(3) Topography: <u>Flat</u> (Hilly) (Flat) (Level)	Black shale		43
(4) Purpose of Well: <u>Domestic</u> (Domestic Irrigation Municipal, Industrial, Other)	Rock		142
Information upon completion of well:	White Chalk		143
(1) Diameter <u>4</u> inches.	Rock		358
(2) Total Depth <u>1219</u> feet.	Sand		359
(3) Water Level <u>80</u> feet below top of ground.	White chalk		413
(4) Cased to <u>490'</u> , Size <u>4"</u>	Sand		510
(5) Screen: Size <u>—</u> , Length <u>—</u>	Concrete		783
(6) Were any formations sealed against pollution? <input checked="" type="checkbox"/> yes, <input type="checkbox"/> no.	Rock		965
If YES depth of formation _____	Rock		966
Why <u>surface &amp; sand</u>	Rock		973
Drillers Remarks: _____	Sand		974
	Rock		1067
	Rock		1150
	Sand		1151
	Rock		1219

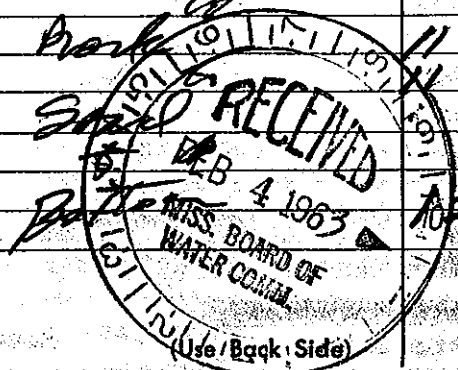

Well No.

Mail this copy to Board of Water Commissioners 429 Miss. St. Jackson, Miss