

QV 2598

Calhoun
08
5-68
Miss. Geo.

MISSISSIPPI
BOARD OF WATER COMMISSIONERS
416 North State Street
Jackson, Mississippi 39201

CODED

WATER WELL DRILLERS LOG

5-7-68 date well completed
68 Robert E. Pattillo firm name
Calhoun county well located

LANDOWNER: Bentley -
Montemista Water
Association Inc.
(mailing address)

description of formations encountered	from	to
Blue shale	0	590
Fine Gray Muddy sand shale	590	700
Fine sand	700	1380
Blue shale	1380	1420
Gray sand	1420	1490
Blue clay	1490	1642
Yellow sand	1642	1720
Pink (mud) clay	1720	1756
Gravel	1756	1900
	1900	2100


WELL LOCATION:
sec 26 T. 22N R. 10E
9 miles So. of Derma
(distance) (direction) (nearest town)

WELL PURPOSE: Community well
(home, irrigation, municipal, industrial)

- WELL COMPLETION DATA:
- (1) diameter (inches) 6x8
 - (2) total depth (feet) 2019
 - (3) static water level (feet) 160 below top of ground.
 - (4) casing Bl. St. 1979 (material) (depth) 6x8 (size) If telescope see back.
 - (5) screen 40' 1979 (length) (depth to top) 6" (size) St. St. (material)
 - (6) pump 20 (HP) 150 (yield gpm) 120 gpm with 138' drawdown electric (type power)
 - (7) electric log yes (USGS # 41) (yes/or no) Elev = 403 M. G. S. (organization running log)
 - (8) how well bottom plugged B.P.U.

CODED

CODED

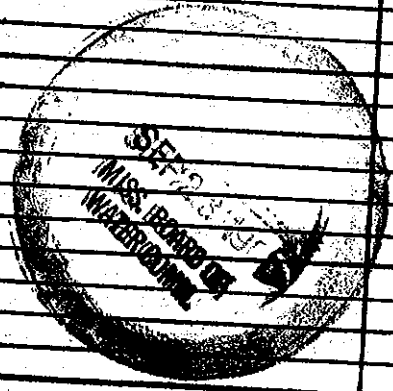

DRILLERS REMARKS: