


CARROLL MISSISSIPPI BOARD OF WATER COMMISSIONERS

A 2
6-20-63


WATER WELL DRILLERS LOG

CODED

Date: 6/20, 1963, Driller: L. L. Louth County Carroll
(Name)

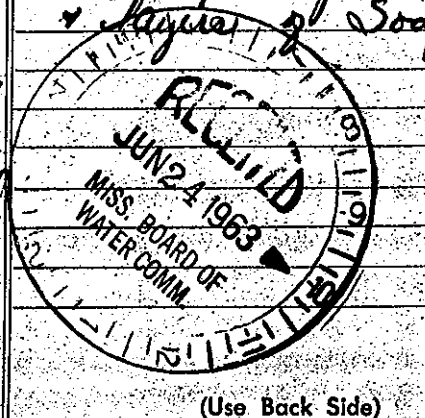(1) Owner of Land:	Description & Color of Materials Sand, Clay, Red Clay, Shell, etc.	Thick- ness Feet	Depth Feet
<u>Wardine Harper</u> (Name) <u>Avalon, Miss.</u> (Address)	<u>1-20 Sand</u>		
(2) Location: <u>1/4</u> , <u>1/4</u> , Sec. <u>22 21 R 2</u> <u>1</u> miles <u>N</u> of <u>Avalon</u> (distance) (direction) (Nearest Town)	<u>20-40 Blue muck</u>		
(3) Topography: <u>level</u> (Hilly) (Flat) (Level)	<u>40-60 Coarse sand</u>		
(4) Purpose of Well: <u>Domestic</u> (Domestic Irrigation Municipal, Industrial, Other)	<u>70-80 gravel</u>		
Information upon completion of well:	<u>80-90 Soapstone</u>		
(1) Diameter <u>2 1/2</u> inches.	<u>89-2" Rock</u>		
(2) Total Depth <u>357</u> feet.	<u>189 89-168 Soapstone & Shale</u>		
(3) Water Level <u>74'</u> feet <u>above</u> top of ground.	<u>168-174 Shale rock</u>		
(4) Cased to <u>189</u> , Size <u>2 1/2"</u>	<u>174-232 green sand soapstone & shale thin alternating strata</u>		
(5) Screen: Size _____, Length _____	<u>232-294 - same as above</u>		
(6) Were any formations sealed against pollution? _____ yes, <input checked="" type="checkbox"/> no.	<u>294-357 - green sand & layers of Soapstone</u>		
If YES depth of formation _____			
Why _____			
Drillers Remarks: <u>This well will flow 20 G.P.M. @ ground level</u>			

CODED

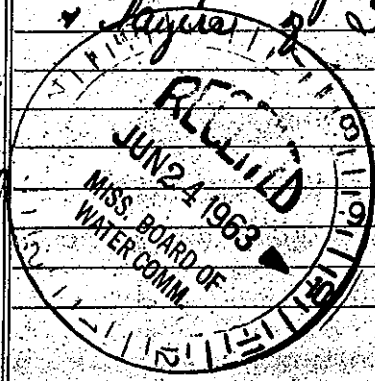

Well No.

(Use Back Side)

Mail this copy to Board of Water Commissioners 429 Miss. St. Jackson, Miss.