

CARROLL MISSISSIPPI BOARD OF WATER COMMISSIONERS

A17  
10-25-65

WATER WELL DRILLERS LOG **CODED**

Date: OCT 25, 1965, Driller: DELTA DRILLING Co County CARROLL  
(Name)

(1) Owner of Land: <u>V. L. MONTGOMERY</u> (Name)	Description & Color of Materials Sand, Clay, Red Clay, Shell, etc.	Thick- ness Feet	Depth Feet
<u>RT. 2, CARROLLTON, MISS</u> (Address)	<u>CLAY</u>	<u>27</u>	<u>27</u>
(2) Location: <u>36 20-2</u> <u>1/4, 1/4, Sec. T. R.</u>	<u>Red sand</u>	<u>40</u>	<u>67</u>
_____ miles _____ of _____ (distance) (direction) (Nearest Town)	<u>Gravel</u>	<u>45</u>	<u>112</u>
(3) Topography: _____ (Hilly) (Flat) (Level)	<u>Shale</u>	<u>12</u>	<u>124</u>
(4) Purpose of Well: <u>Domestic</u> (Domestic Irrigation Municipal, Industrial, Other)	<u>gumbo</u>	<u>20</u>	<u>144</u>
	<u>Shale</u>	<u>10</u>	<u>154</u>
	<u>Sand</u>	<u>64</u>	<u>218</u>

Information upon completion of well:


- (1) Diameter 2 inches.
- (2) Total Depth 218 feet.
- (3) Water Level 168' feet below top of ground.
- (4) Cased to 212, Size 2
- (5) Screen: Size 6', Length 2"  
S.S. SCREEN
- (6) Were any formations sealed against pollution?  
\_\_\_\_\_ yes, \_\_\_\_\_ no.

If YES depth of formation \_\_\_\_\_

Why \_\_\_\_\_

Drillers Remarks: 203' - pump setting

**CODED**

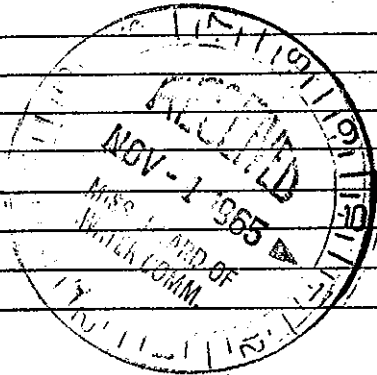

(Use Back Side)

Well No.

Mail this copy to Board of Water Commissioners 429 Miss. St. Jackson, Miss.