	I STATE WELL REPORT	
county: Franklin	Part 1	For Office Use Only:
	Driller's Log	Well #: A UU
Permit #:	Mississippi Department of Environmental Quality	Aquifer:
Driller: Gary Rayborn	Office of Land and Water Resources P.O. Box 2309	E-Log #:
Date drilling completed: 12/10/15	Jackson, MS 39225-2309	E-LOg #
	(601)961-5210	
	(601)360-0535 (fax)	

ł

State Law requires that this report be prepared by the license holder responsible for the work and filed with the Department at the above address within 30 days of completion of drilling of the well or borehole.

Department at the above address within 30 days of con	
Well Owner Information	Well or Borehole Location
(Landowner if borehole is not for a water well)	Latitude: <u>31°31′47′N</u> Longitude: <u>91°9′3′′W</u>
Owner Name: Latta Ratcliffe	Method of Lat/Long (check one): Conventional Survey,
Mailing Address:	USGS quad, Hand-held GPS, Survey-grade GPS
207 Winchester Rd.	
Natchez MS 39120	<u>IL 14 IL 14, Sec 45 T 7N RIE</u>
City State Zip Code	5_Miles of OKIE
Telephone No. (601) 870-9575	(Distance) (Direction) (Nearest Town)
	orehole Data
Date drilling started: $\frac{129}{15}$ Date drilling completed:	12/10/15 Hole depth: 80 Hole diameter: 4
Location of the source of any surface water used for drillir	
Method of dosing and volume of Chlorine used in drilling a	
Logs run (circle all applicable) No log run Electric Gamm	
Name of organization running log(s):	
	ical/Geological Investigation Ground Source Heat Pump
	(describe)
If drilling is not related to water well c	construction, skip the remainder of this block
Purpose of Well (circle all applicable): Home Industrial	Public Supply Irrigation Fish Culture
Other (describe):	
If a flowing well, method of flow regulation: Valve	Other (describe)
Static Water Level: <u>50</u> feet [above or below (circle one)	
Method of measurement (circle one): Steel tape (Electric	tape Air line Other (describe):
Well depth: 80 Well grouted to a depth of: 10	feet Type of grout (circle one): Neat Cement Bentonite Mix
Casing length: <u>60</u> feet Casing diameter:	<u>4</u> inches Type of casing: <u>PVC</u>
Screen length: <u>20</u> feet Screen diameter:	
Screen slot size: <u>• O I O</u> inches Setting depth	r: From <u>60</u> feet to <u>80</u> feet
Type of completion (circle all applicable): Gravel packed	Underreamed Open hole Natural Development
Other (describe):	
Top of lap pipe or reduction in casing:feet	DEC 1 6 2015

If telescoped or more than one screen, describe on next page

County:	Franklin	
Permit #:		


For Office Use Only:

)

٠


Well #: _____

The sketch below only required for water wells

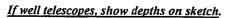

K

Ground Level

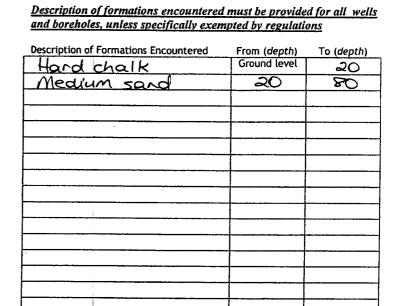

.

If more than one screen, show location of each on sketch

Sketch the property layout and include the following:
4) the well logation
2) any permanent structures on the property that may aid in locating the well 3) any roads, power lines, or other items that may aid in locating the property and the well
3) any roads, power lines, or other items that may aid in locating the property and the well
A) porth arrow
Location they by Log Cabin Rd.
Logaron Lugar Lugar
vert de la log caut
well
Sqroly Greek user
High Re
Roxie
Huy
Landowner Name: Latta Ratcliffe
I HEREBY CERTIFY that the well/borehole was drilled, constructed, and completed in accordance with all applicable
requirements of the Mississippi Department of Environmental Quality and the Mississippi Department of Health regulations,
if applicable, and state laws.
Kaybon Drilling Trc. 0-60 12/10/15
Kaybon Drilling Trc. 0-60 12/10/15
Form: OLWR-SWR-1A (4/13)

For Office Use Only:		
ell #: A22		
uifer:		
nstaller. A copy of Part 1 n 30 days of well completion. tion		
de: $91^{9}3''W$		
, Survey-grade GPS		
Notchez MS 39120 4, sec 45 T 7N R IE City State Zip Code 5 Miles W of ROXIE		
(Nearest Town)		
(Neurest Tomi)		
be):		
Gallons Per Minute		
Stages:		
4 hours): hours		
Feet Below Land Surface		
O Gallons Per Minute		
ours of pumping		
ours of pumping		
d to manufacturer standards.		
d to manufacturer standards.		
d to manufacturer standards. site.		

.

_

5 F