

CARROLL

A 41

5-2-62

MISSISSIPPI BOARD OF WATER COMMISSIONERS

Code

WATER WELL DRILLERS LOG

A

Date: MAY 2, 1962, Driller: DELTA DRILLING CO County CARROLL

(Name)

	Description & Color of Materials Sand, Clay, Red Clay, Shell, etc.	Thick- ness Feet	Depth Feet
(1) Owner of Land: <u>MALISSIA LIGHTNING LEVERTA CURRY</u> (Name)	<u>CLAY</u>	<u>22</u>	<u>22</u>
<u>RTE. 2, BOX 455, GREENWOOD, MISS</u> (Address)	<u>SAND</u>	<u>42</u>	<u>64</u>
(2) Location: <u>SW 1/4, NE 1/4, Sec. 27 T20R2E</u>	<u>GRAVEL</u>	<u>12</u>	<u>76</u>
_____ miles _____ of _____ (distance) (direction) (Nearest Town)	<u>SAND</u>	<u>36</u>	<u>112</u>
(3) Topography: _____ (Hilly) (Flat) (Level)	<u>GUMBO</u>	<u>16</u>	<u>128</u>
(4) Purpose of Well: <u>DOMESTIC</u> (Domestic Irrigation Municipal, Industrial, Other)	<u>GREEN SAND - 5" ROCK</u>	<u>83</u>	<u>211</u>
	<u>SHALE</u>	<u>12</u>	<u>223</u>
	<u>GREEN SAND</u>	<u>116</u>	<u>339</u>

Information upon completion of well:


- (1) Diameter 2 inches.
- (2) Total Depth 339 feet.
- (3) Water Level FLWS - feet below top of ground.
- (4) Cased to 339, Size 2"
- (5) Screen: Size 2", Length 63'-2"
PERFORATED PIPE
- (6) Were any formations sealed against pollution?
_____ yes, _____ no.

If YES depth of formation _____

Why _____

Drillers Remarks: WELL FLOWS -

30 GPM.

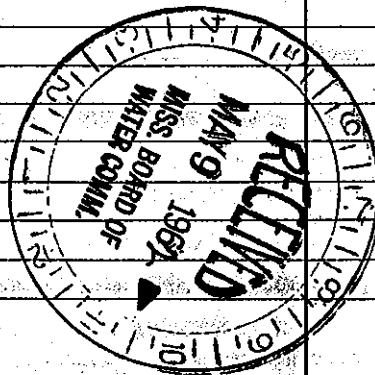

(Use Back Side)

Well No.

Mail this copy to Board of Water Commissioners 429 Miss. St. Jackson.