

CARROLL MISSISSIPPI BOARD OF WATER COMMISSIONERS

A 48

CODED


WATER WELL DRILLERS LOG

7-22-64

Date: JULY 22, 1964, Driller: DELTA DRILLING Co. County: CARROLL

(Name)

(1) Owner of Land: <u>MRS. J. P. McCAIN</u> WELL LOCATED (Name) <u>TEOG, MISS</u> <u>GREENWOOD</u> (Address)	Description & Color of Materials Sand, Clay, Red Clay, Shell, etc.	Thick- ness Feet	Depth Feet
(2) Location: <u>SE 1/4, SW 1/4, Sec. 14 T2N R2E</u> _____ miles _____ of _____ (distance) (direction) (Nearest Town)	SAND	22	22
(3) Topography: _____ (Hilly) (Flat) (Level)	GUMBO	30	52
(4) Purpose of Well: <u>DOMESTIC</u> (Domestic Irrigation Municipal, Industrial, Other)	SAND	28	80
Information upon completion of well:	GRAVEL	12	92
(1) Diameter <u>4</u> inches.	GUMBO	17	109
(2) Total Depth <u>466</u> feet.	SHALE W/ROCKS -	39	148
(3) Water Level _____ feet below top of ground.	SAND W/ROCKS -	53	201
(4) Cased to <u>445</u> , Size <u>10 5/8" 4" pipe</u> , Size <u>340' 2"</u>	SHALE	26	227
(5) Screen: Size <u>2"</u> , Length <u>21' 2"</u> PERFORATED PIPE	GUMBO	12	239
(6) Were any formations sealed against pollution? _____ yes, _____ no.	SAND W/ 1/4" ROCK	57	290
If YES depth of formation _____	GUMBO	30	320
Why _____	SAND	6	326
Drillers Remarks: <u>75M1-5CB Red Jacket</u> <u>Deep well submersible pump</u> <u>Complete w/ 120 gal Tank</u> <u>installed in well.</u>	SHALE	22	348
	GUMBO	20	368
	SHALE	15	383
	GUMBO	14	397
	SAND	12	409
	SHALE	26	435
	SAND	23	458
	GUMBO	8	466

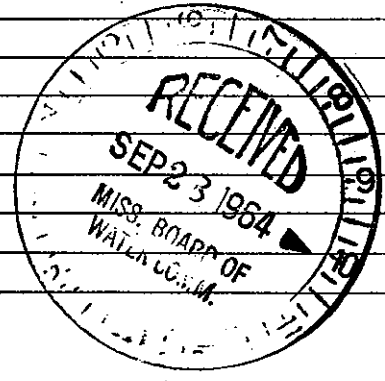

(Use Back Side)

Well No.

Mail this copy to Board of Water Commissioners 429 Miss. St. Jackson, Miss