

A50

Carroll

WATER WELL DRILLERS LOG

COOED

Date: 3/16 ³⁻⁶⁶, 1966, Driller: L. F. Cutts County Carroll

(Name)

(1) Owner of Land: Calvin Turner
(Name)
Avalon, Miss
(Address)

(2) Location: NW 1/4, NW 1/4, Sec. 26 TN RE
(distance) 1 miles east, of Avalon
(direction) (Nearest Town)

(3) Topography: level
(Hilly) (Flat) (Level)

(4) Purpose of Well: Domestic
(Domestic Irrigation)
(Municipal, Industrial, Other)

Description & Color of Materials Sand, Clay, Red Clay, Shell, etc.	Thick- ness Feet	Depth Feet
Dirt	21	21
Blue mucky	21	42
blue sand	21	63
gravel	7	70
Soapstone	25	95
Rock (hard)	10"	
Shale & soapstone	9	104
Rock (hard)	4"	
Soapstone	1	105
Soapstone & shale	15	120
green sand	19	139
Rock (hard)	3"	
brown sand	8	147
green sand	18	165
Soapstone	3	168
Shale & soapstone	32	200
green sand	23	223
Soapstone	19	242
green sand	13	255
Shale & soapstone	18	273
green sand & soapstone	52	325
Soapstone	28	353
white sand	4	357
Soapstone	13	370
green sand	8	378
Soapstone	63	441
White sand	42	483

Information upon completion of well:

(1) Diameter 2 1/2 inches.

(2) Total Depth 483 feet.

(3) Water Level 4 feet ^{above} below top of ground.

(4) Cased to 126' 2 1/2", Size 360' 9 1/4"


(5) Screen: Size Perf 1 1/4" Length 42'

(6) Were any formations sealed against pollution?
 _____ yes, no.

If YES depth of formation _____

Why _____

Drillers Remarks: Will flow about 4 or 5 gal. per minute.

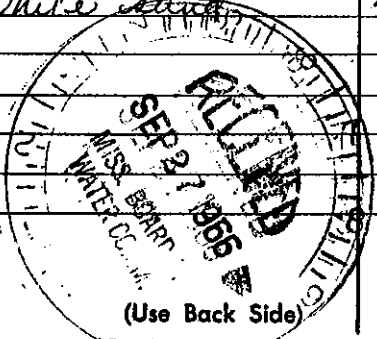

Well No. _____

Mail this copy to Board of Water Commissioners 429 Miss. St. Jackson, Miss