

State Well Report Part 1 - Driller's Log

Mississippi Department of Environmental Quality
Office of Land and Water Resources
P.O. Box 10631
Jackson, MS 39289-0631
(601)961-5210
(601)354-6938 (fax)

County: Cassell
 Permit #: _____
 Driller: RATLIFF
 Date drilling completed: 1-16-07

For Office Use Only:
 Aquifer: _____
 Well #: A-85
 L. S. Elevation: _____
 E-log #: _____

State Law requires that this report be prepared by the license holder responsible for the work and filed with the Department at the above address within 30 days of completion of drilling of the well or borehole.

<p align="center">Information on Well Owner (Landowner if borehole is not for a water well)</p> <p>Owner Name: <u>Gilbert Cobb</u> Mailing Address: <u>CR 193</u> <u>Cassellton, MS 38917</u> City State Zip Code Telephone No. () _____</p>	<p align="center">Well or Borehole Location</p> <p>Latitude: " ' " Longitude: " ' " "</p> <p>Method of Lat/Long (circle one): Conventional Survey, USGS quad, Hand-held GPS, Survey-grade GPS</p> <p><u>1/4</u> <u>1/4</u> Sec <u>14</u> Twn <u>20N</u> Rng <u>R 2E</u></p> <p>Distance Direction Nearest Town <u>10</u> Miles <u>NE</u> of <u>Greenwood</u></p>
--	---

Well / Borehole Data

Date drilling started: 1-16-07 Date drilling completed: 1-16-07 Hole depth: 190 Hole diameter: 8 1/4

Location of the source of any surface water used for drilling: N/A
 Method of dosing and volume of Chlorine used in drilling and development: N/A

Logs run (circle all applicable): (No log run) Electric Gamma Ray Density Sonic Neutron Other: _____
 Name of organization running log(s): _____

Purpose of borehole (check one): Water Well Geotechnical/Geological Investigation _____ Ground Source Heat Pump _____
 Seismic Survey _____ Other (describe) _____
If drilling is not related to water well construction, skip the remainder of this block

Purpose of Well (check one): Home Industrial _____ Public Supply _____ Irrigation _____ Fish Culture _____ Other: _____

If a flowing well, method of flow regulation: Valve _____ Other (describe) _____

Static Water Level: _____ feet above or below (circle one) land surface Date measured: _____

Method of Measurement (circle one) steel tape electric tape air line other: _____

Well depth: 185 Well grouted to a depth of 10 feet Type of grout (circle one): Neat Cement (Bentonite) Mix

Casing length: 175 feet Casing diameter: 4 inches Type of casing: PVC

Screen length: 10 feet Screen diameter: 4 inches Type of screen: PVC

Screen slot size: 10 inches Setting depth: From 175 feet to 185 feet

Type of completion (circle all applicable): (Gravel packed) Underreamed Telescoped Open hole Natural Development
 Other (describe): _____

Top of lap pipe or reduction in casing: N/A feet. *If telescoped or more than one screen, describe on next page*

Form: OLWR-SWR-1A


RECEIVED
MAY 14 2007
BY: OLWR

A.85

The sketch below only required for water wells

Description of formations encountered must be provided for all wells and boreholes, unless specifically exempted by regulations


If well telescopes, show depths on sketch
Ground Level →

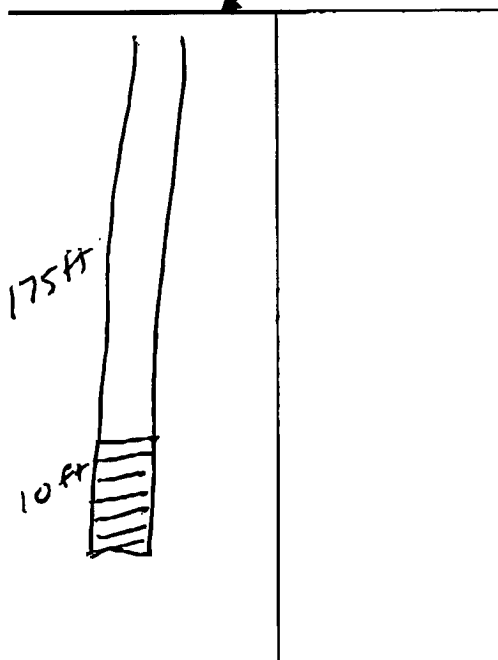

Description of Formations Encountered	From (depth)	To (depth)
gravel + sand	Ground Level	50
sand + clay	50	70
clay	70	89
Rock	89	90
clay + sand	90	150
Rock	159	160
clay + sand	160	175
sand	175	190

If more than one screen, show location of each on sketch

Sketch the property layout and include the following: 1) the well location; 2) any permanent structures on the property that may aid in locating the well; 3) any roads, power lines, or other items that may aid in locating the property and the well; 4) a north arrow.

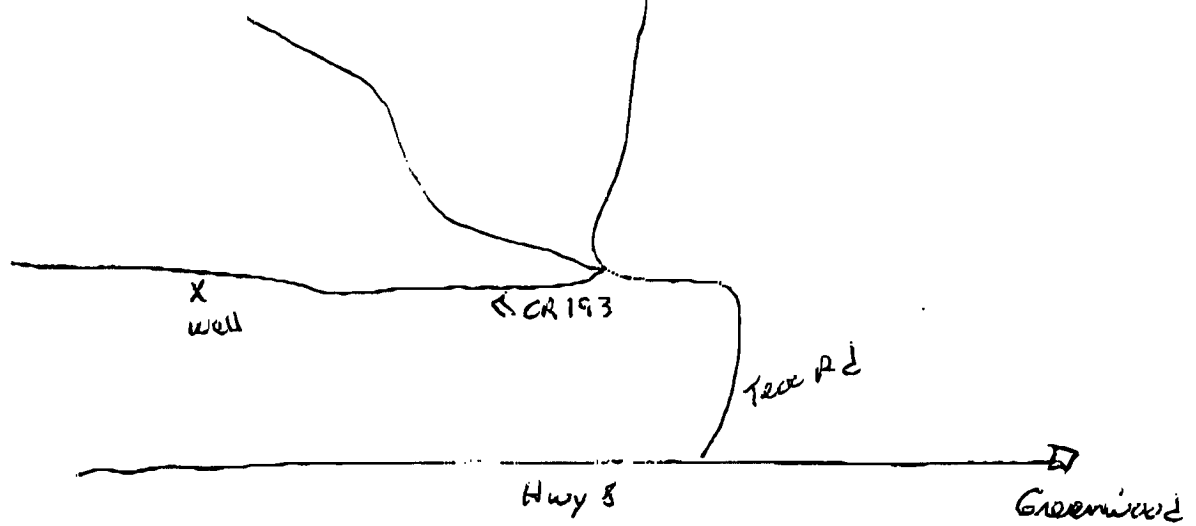

Landowner Name: Gilbert Cobb

Form: OLWR-SWR-1A

I certify that the well/borehole was drilled, constructed, and completed in accordance with all applicable requirements of the Mississippi Department of Environmental Quality and the Mississippi Department of Health regulations, if applicable, and state laws.

Robert RATLIF 0-002 1-16-07

Robert Ratliff
Signature of Licensee

RECEIVED
MAY 14 2007
BY: OLWR

STATE WELL REPORT

Part 2

Pump Installer's Completion Report
 Mississippi Department of Environmental Quality
 Office of Land and Water Resources
 P.O. Box 10631
 Jackson, MS 39289-0631
 (601)961-5210
 (601)354-6938 (fax)

County: Cannell
 Permit #: _____
 Driller: RATLIFF
 Date completed: 1-16-07
Copy information from block on Part 1

For Office Use Only:
 Aquifer: _____
 Well #: A-85
 Elevation: _____

This part of the report must be completed by a licensed water well contractor or a licensed pump installer. A copy of Part 1 of the report must be attached and both parts filed with the Department at the above address within 30 days of well completion.

Well Owner Information	Well Location
Owner Name: <u>Gilbert Cobb</u>	Latitude: _____ Longitude: _____
Mailing Address: <u>CR 193</u>	Method of Lat/Long (check one): Conventional Survey _____
<u>Cannellton, MS 38987</u>	USGS quad _____, Hand-held GPS _____, Survey-grade GPS _____
City State Zip Code	_____ 1/4 _____ 1/4 Sec <u>14</u> T <u>20N</u> R <u>2E</u>
Telephone No. () _____	Distance Direction Nearest Town
	<u>1.0</u> Miles <u>NE</u> of <u>Greenwood</u>

Pump Type Circle one	Power Type Circle one
Air Lift Jet <input checked="" type="radio"/> <u>Submersible</u>	Diesel Engine Gasoline Engine Natural Gas
Bucket Piston Turbine	<input checked="" type="radio"/> <u>Electric Motor</u> Hand Tractor PTO
Centrifugal Rotary Flowing Well	Windmill Other (specify): _____
Other (specify): _____	Horse Power Rating of Motor: <u>1/2 hp</u>
Date Pump Installed: <u>1-16-07</u>	Setting Depth: <u>80 ft</u> feet
Rated Pump Capacity: <u>5</u> Gallons Per Minute	Number of Stages: <u>5</u>

Pump Test Data	Method of Measuring Water Level Circle one
Date Well Tested: _____	Air Line Electric Measuring Line Steel Tape
Static Water Level (A): _____ Feet Below Land Surface	Other (specify): _____
Pumping Water Level (B): _____ Feet Below Land Surface	For flowing well, measured shut in head: _____ feet
Drawdown [(B) - (A)]: _____ Feet Below Land Surface	Well yielded _____ GPM with a drawdown of _____ feet after _____ hours of pumping
Test Pumping Rate: _____ Gallons Per Minute	
Duration of Pump Test (minimum 4 hours): _____ hours	

I HEREBY CERTIFY that the above statements are true to the best of my knowledge.

Robert Ratliff 0-002 Robert Ratliff
 Print Name of Pump Installer and License No. (if applicable) Signature of Pump Installer

Form: OLWRSWR-12
RECEIVED
 MAY 14 2007
 BY: OLWR