

CARROLL

MISSISSIPPI BOARD OF WATER COMMISSIONERS

B1

CODED

1-18-66

WATER WELL DRILLERS LOG


E Log# 27 USGS

CARROLL

Date: JAN 18, 1966, Driller: DELTA DRILLING Co County: ~~DELAWARE~~

(Name)

		Description & Color of Materials Sand, Clay, Red Clay, Shell, etc.	Thick- ness Feet	Depth Feet
(1) Owner of Land: <u>DAVE GEORGE</u> (Name)		Clay	31	31
<u>Carrollton, MISS.</u> (Address)		gravel	13	44
(2) Location: <u>NW 1/4 SE 1/4 SW 1/4, Sec. 32 T40R3E</u>		Red Sand	18	62
_____ miles _____ of _____ (distance) (direction) (Nearest Town)		gravel	32	94
(3) Topography: _____ (Hilly) (Flat) (Level)		Sand	94	188
(4) Purpose of Well: <u>DOMESTIC</u> (Domestic Irrigation Municipal, Industrial, Other)		gumbo	31	219
		green shale w/rocks	49	268
		green sand	41	309
		Shale w/rock	23	332
		green sand w/rock	21	353
		shale w/rock	51	404
		green sand	26	430
		SHALE w/rock	25	455
		Sand w/shale	14	469
Information upon completion of well:				
(1) Diameter: <u>4</u> inches.				
(2) Total Depth: <u>469</u> feet.				
(3) Water Level: <u>160</u> feet below top of ground.				
(4) Cased to: <u>410</u> , Size: <u>4" - 250'</u> <u>2" - 160'</u>				
(5) Screen: Size _____, Length _____				
(6) Were any formations sealed against pollution? _____ yes, _____ no.				
If YES depth of formation _____				
Why _____				
Drillers Remarks: <u>231' PUMP SETTING</u>				

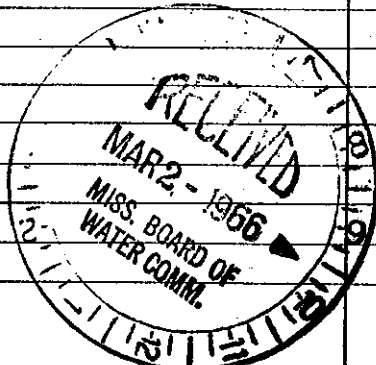

(Use Back Side)

Well No.

copy to Board of Water Commissioners 429 Miss. St. Jackson, Miss