

CODED

Carroll
B3
9-12-68

MISSISSIPPI
BOARD OF WATER COMMISSIONERS
416 North State Street
Jackson, Mississippi 39201

WATER WELL DRILLERS LOG

SEPT 12, 1968 DELTA DRILLING CO. CARROLL
date well completed firm name county well located

LANDOWNER: C.E. JACKS
GREENWOOD, MISS
(mailing address)


description of formations encountered	from	to
CLAY	-0-	22
RED SAND	22	70
gravel	70	105
Sand	105	190
gumbo	190	211

WELL LOCATION: SE 1/4 NW 1/4
sec. 28 T 20 N R 3 E
(distance) miles of (direction) (nearest town)

WELL PURPOSE: DOMESTIC
(home, irrigation, municipal, industrial)

CODED

- WELL COMPLETION DATA:
- (1) diameter (inches) 4"
 - (2) total depth (feet) 211
 - (3) static water level (feet) 106 below above top of ground.
 - (4) casing STEEL, 168 (material), (depth)
4-2 (size) if telescope see back.
 - (5) screen 10, 168 (length), (depth to top)
2, SSTEEL (size), (material)
 - (6) pump 3/4 (HP), (yield gpm)
ELEC (type power)
 - (7) electric log NO (yes or no)
✓ (organization running log)

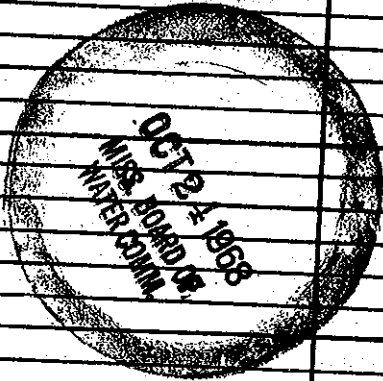

(8) how well bottom plugged BACK PRESSURE VALVE

DRILLERS REMARKS: WELL SET
178'- PUMP SETTING
166'-