

CARROLL

MISSISSIPPI BOARD OF WATER COMMISSIONERS

Bone

B15

WATER WELL DRILLERS LOG

CODED

9-15-60

Date: 9-15, 1960, Driller: PITANE GAS CO OF GREENWOOD

CARROLL

LOFLOR

(Name)

(1) Owner of Land: JESSIE MCCRORY

(Name)

CORRECTION, MISS

(Address)

(2) Location: 1/4, 1/4, Sec. 9 T20R3

9 miles NE.

(direction)

of CORRECTION

(Nearest Town)

(3) Topography: Hilly

(Hilly)

(Flat)

(Level)

(4) Purpose of Well: DOMESTIC

(Domestic Irrigation
Municipal, Industrial, Other)

Description & Color of Materials
Sand, Clay, Red Clay, Shell, etc.

Thick-
ness
Feet

Depth
Feet

RED CLAY	10	10
RED SAND	86	96
CLAY & SHALE	18	114
RED SAND	76	190
BLUE CLAY	25	215
SHALE	41	260
SAND (WHITE)	18	278
SAND (GREEN)	15	293

Information upon completion of well:

(1) Diameter 2 inches.

(2) Total Depth 293 feet.

(3) Water Level 170 feet below top of ground.

(4) Cased to 293', Size 2"

(5) Screen: Size 2", Length 10

(6) Were any formations sealed against pollution?


yes, X no.

If YES depth of formation

Why

Drillers Remarks:

CODED

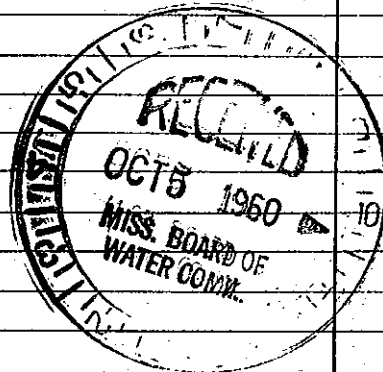

Well No.

(Use Back Side)

Mail this copy to Board of Water Commissioners 429 Miss. St. Jackson, Miss