

COMMISSIONERS

CARROLL
B16
3761

WATER WELL DRILLER


CODED *OR*
WKS

Date: March, 1961, Driller: Robert E. Rolliff County Carroll
(Name)

(1) Owner of Land: <u>Mike Beckwith</u> (Name) <u>North Carrollton, Miss</u> (Address)	Description & Color of Materials Sand, Clay, Red Clay, Shell, etc.	Thick- ness Feet	Depth Feet
(2) Location: <u>1/4</u> , <u>1/4</u> , Sec. <u>21 T²⁰R³E</u>	<u>Clay</u>	<u>0</u>	<u>34</u>
<u>6</u> miles <u>WEST</u> of <u>Carrollton</u> (distance) (direction) (Nearest Town)	<u>Sand</u>	<u>34</u>	<u>39</u>
(3) Topography: <input checked="" type="checkbox"/> (Hilly) <input type="checkbox"/> (Flat) <input type="checkbox"/> (Level)	<u>Gravel</u>	<u>39</u>	<u>42</u>
(4) Purpose of Well: _____ (Domestic Irrigation Municipal, Industrial, Other)	<u>Sand</u>	<u>42</u>	<u>79</u>
	<u>Clay</u>	<u>79</u>	<u>84</u>
	<u>Sand</u>	<u>84</u>	<u>111</u>
	<u>Shale</u> CODED	<u>111</u>	<u>160</u>
	<u>Rock</u>	<u>160</u>	<u>161</u>
	<u>Shale</u>	<u>161</u>	<u>163</u>
	<u>Rock</u>	<u>163</u>	<u>164</u>
	<u>Shale & Sand</u>	<u>164</u>	<u>210</u>
	<u>Sand & Shale</u>	<u>210</u>	<u>225</u>
	<u>Rock's</u>	<u>225</u>	<u>226</u>
	<u>Shale</u>	<u>226</u>	<u>239</u>
	<u>Rock</u>	<u>239</u>	<u>240</u>
	<u>Shale</u>	<u>240</u>	<u>246</u>
	<u>Rock</u>	<u>246</u>	<u>247</u>
	<u>Shale</u>	<u>247</u>	<u>254</u>
	<u>Rock</u>	<u>254</u>	<u>255</u>
	<u>Shale & Sand</u>	<u>255</u>	<u>281</u>
	<u>Rock</u>	<u>281</u>	<u>282</u>
	<u>Sand</u>	<u>282</u>	<u>312</u>
	<u>Shale & Sand</u>	<u>312</u>	<u>335</u>

Information upon completion of well:

- (1) Diameter 2x4 inches.
- (2) Total Depth 335 feet.
- (3) Water Level 80 feet below top of ground.
- (4) Cased to 212', Size 4", 87', Size 2"
- (5) Screen: Size 2", Length 5'
- (6) Were any formations sealed against pollution?
 yes, no.

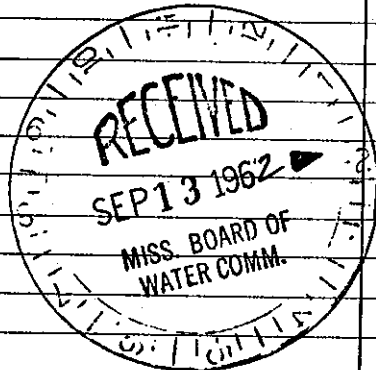

(Use Back Side)

Well No.

Mail this copy to Board of Water Commissioners 429 Miss. St. Jackson, Miss.