

CARROLL  
B17  
4-61

MISSISSIPPI BOARD OF WATER COMMISSIONERS

WATER WELL DRILLERS

**CODED** <sup>HS</sup>


Date: April, 1961, Driller: Robert E. Rolliff County Carroll  
(Name)

(1) Owner of Land: <u>Lloyd Cambell</u> (Name)	Description & Color of Materials Sand, Clay, Red Clay, Shell, etc.	Thick- ness Feet	Depth Feet
<u>Carrollton, Miss.</u> (Address)	<u>Surface Soil</u>	<u>0</u>	<u>10</u>
(2) Location: <u>1/4, 1/4, Sec. 35 T20 R3</u>	<u>Sandy Formations</u>	<u>10</u>	<u>100</u>
<u>6</u> miles <u>North West</u> <u>Carroll</u> (distance) (direction) (Nearest Town)	<u>Sand &amp; Gravel</u>	<u>100</u>	<u>150</u>
(3) Topography: <input checked="" type="checkbox"/> (Hilly) <input type="checkbox"/> (Flat) <input type="checkbox"/> (Level)	<u>Sandy Clay</u>	<u>150</u>	<u>250</u>
(4) Purpose of Well: <u>Domestic</u> (Domestic Irrigation, Municipal, Industrial, Other)	<u>Rock &amp; clay</u>	<u>250</u>	<u>300</u>
	<u>Green Sand</u>	<u>300</u>	<u>375</u>
	<u>Clay</u>	<u>375</u>	<u>400</u>
	<u>Sandy Clay</u>	<u>400</u>	<u>490</u>
	<u>Good coarse Sand</u>	<u>490</u>	<u>552</u>

Information upon completion of well:

- (1) Diameter 4x2 inches.
  - (2) Total Depth 552 feet.
  - (3) Water Level 138 feet below top of ground.
  - (4) Cased to 400' 4" 2" Size 2"
  - (5) Screen: Size 2", Length 10'
  - (6) Were any formations sealed against pollution?  
 yes,  no.
- If YES depth of formation cased
- Why \_\_\_\_\_
- Drillers Remarks: 15 GPM

**CODED**

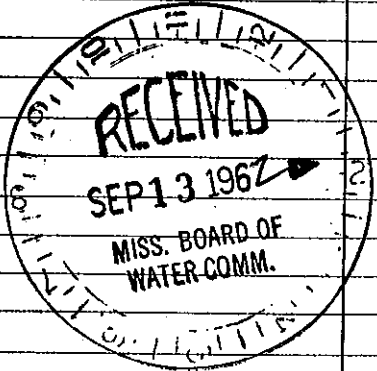

Well No.

(Use Back Side)

Mail this copy to Board of Water Commissioners 429 Miss. St. Jackson, Miss.