

CARROLL MISSISSIPPI BOARD OF WATER COMMISSIONERS

B-300

B 37

WATER WELL DRILLERS LOG

8-31-60

Date: 8-31, 1960, Driller: Jack Martin County Carroll

		Thick- ness Feet	Depth Feet
(1) Owner of Land: <u>H. L. Holman</u> (Name)	Color of Materials Sand, Clay, Red Clay, Shell, etc.		
<u>Carrollton</u> (Address)	<u>Red Clay</u>	<u>16</u>	<u>16</u>
(2) Location: <u>SW 1/4, NE 1/4, Sec. 36 T20R3</u>	<u>Sand</u>	<u>6</u>	<u>22</u>
<u>3</u> miles <u>N</u> of <u>Carrollton</u> (distance) (direction) (Nearest Town)	<u>clay</u>	<u>6</u>	<u>28</u>
(3) Topography: <u>Hilly</u> (Hilly) (Flat) (Level)	<u>Sand</u>	<u>90</u>	<u>118</u>
(4) Purpose of Well: <u>Domestic</u> (Domestic Irrigation Municipal, Industrial, Other)			


Information upon completion of well:

- (1) Diameter 2 inches.
- (2) Total Depth 117 feet.
- (3) Water Level _____ feet below top of ground.
- (4) Cased to 112, Size 2
- (5) Screen: Size 2", Length 5'
- (6) Were any formations sealed against pollution?
_____ yes, no.

If YES depth of formation _____

Why _____

Drillers Remarks: Water Sand
from 86-118

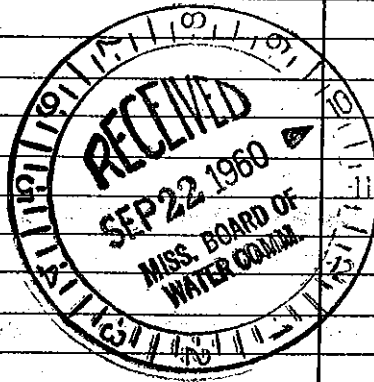

Well No.

(Use Back Side)

Mail this copy to Board of Water Commissioners 429 Miss. St. Jackson, Miss.