

CARROLL MISSISSIPPI BOARD OF WATER COMMISSIONERS

B *78*

8-26-60

WATER WELL DRILLERS LOG

B-301

Date: *8-26*, 19 *60*, Driller: *Jack Martin* County *Carroll*
(Name)

(1) Owner of Land: *J. L. Dunn*
(Name)
Carrollton
(Address)

(2) Location: *NW 1/4, NE 1/4, Sec. 34 T. 20 R. 3*
(distance) (direction) (Nearest Town)
5 miles *NW* of *Carrollton*

(3) Topography: *Hilly*
(Hilly) (Flat) (Level)

(4) Purpose of Well: *Domestic*
(Domestic Irrigation Municipal, Industrial, Other)

Description & Color of Materials Sand, Clay, Red Clay, Shell, etc.	Thick- ness Feet	Depth Feet
<i>Red clay</i>	<i>22</i>	<i>22</i>
<i>clay-sand-gravel</i>	<i>7</i>	<i>29</i>
<i>sand</i>	<i>49</i>	<i>78</i>
<i>pipe clay</i>	<i>22</i>	<i>100</i>

Information upon completion of well:

(1) Diameter *2* inches.

(2) Total Depth *78* feet.

(3) Water Level *64* feet below top of ground.

(4) Cased to *73*, Size *2*.


(5) Screen: Size *2*, Length *5*.

(6) Were any formations sealed against pollution?
 _____ yes, no.

If YES depth of formation _____

Why _____

Drillers Remarks: _____

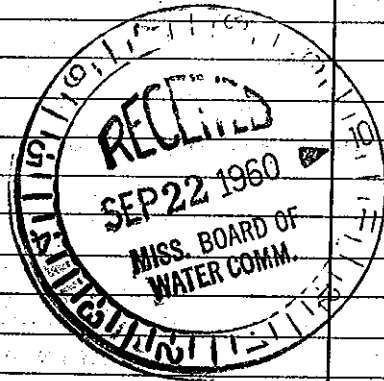

Well No.

(Use Back Side)

Mail this copy to Board of Water Commissioners 429 Miss. St. Jackson, Miss.