

CARROLL MISSISSIPPI BOARD OF WATER COMMISSIONERS

B 41

5-20-64

WATER WELL DRILLERS LOG

Date: MAY 20, 1964, Drillers: DELTA DRILLING Co. County: CARROLL  
 (Name)

(1) Owner of Land: <u>WALLACE H. JACKSON</u> (Name)	Description & Color of Materials Sand, Clay, Red Clay, Shell, etc.	Thick- ness Feet	Depth Feet
<u>RTE. 3, CARROLLTON, MISS.</u> (Address)	CLAY	26	26
	SAND	17	43
	GRAVEL	44	87
(2) Location: <u>SW 1/4, NW 1/4, Sec. 20 T20R3E</u>	SAND	50	137
_____ miles _____ of _____ (distance) (direction) (Nearest Town)	SHALE	31	168
	SAND	23	191
(3) Topography: _____ (Hilly) (Flat) (Level)	GUMBO	43	234
	SAND	17	251
(4) Purpose of Well: <u>DOMESTIC</u> (Domestic Irrigation, Municipal, Industrial, Other)	GUMBO	15	266
	SAND	16	282
	GUMBO	12	294

Information upon completion of well:

- (1) Diameter 4" inches.
- (2) Total Depth 294 feet.
- (3) Water Level \_\_\_\_\_ feet below top of ground.
- (4) Cased to 284, Size \_\_\_\_\_
- (5) Screen: Size 2" Length 20'  
PERFORATED PIPE
- (6) Were any formations sealed against pollution?  
\_\_\_\_\_ yes, \_\_\_\_\_ no.

If YES depth of formation \_\_\_\_\_


Why \_\_\_\_\_

Drillers Remarks: 3/4 H.P. RED JACK

ET PUMP SET IN WELL

W/10' 2" TAIL PIPE ON

BOTTOM END OF WELL.

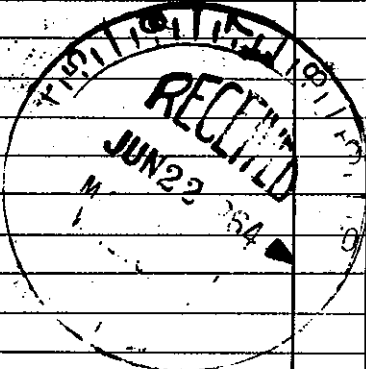

Well No.

(Use Back Side)