

CARROLL MISSISSIPPI BOARD OF WATER COMMISSIONERS

B 42

7-64

WATER WELL DRILLERS LOG

Date: July, 1964, Driller: Jack Martin County Holmes  
(Name)

(1) Owner of Land: <u>R. L. Stephenson</u> <small>(Name)</small>	Description & Color of Materials Sand, Clay, Red Clay, Shell, etc.	Thick- ness Feet	Depth Feet
<u>Carrollton</u> <small>(Address)</small>	<u>Clay</u>	<u>16</u>	<u>16</u>
(2) Location: <u>SE 1/4, NW 1/4, Sec. 24 T. 25 R. 25E</u>	<u>Sand</u>	<u>102</u>	<u>118</u>
<u>4</u> miles <u>N</u> of <u>Carrollton</u> <small>(distance) (direction) (Nearest Town)</small>	<u>Pipeclay Sand</u>	<u>14</u>	<u>132</u>
(3) Topography: <u>Hilly</u> <small>(Hilly) (Flat) (Level)</small>	<u>Sand</u>	<u>53</u>	<u>185</u>
(4) Purpose of Well: <u>Domestic</u> <small>(Domestic Irrigation Municipal, Industrial, Other)</small>			

Information upon completion of well:

(1) Diameter 2 inches.

(2) Total Depth 185 feet.

(3) Water Level 124 feet below top of ground.

(4) Cased to 180, Size 2 1/2.


(5) Screen: Size 2, Length 5.

(6) Were any formations sealed against pollution?  
 yes,  no.

If YES depth of formation \_\_\_\_\_

Why \_\_\_\_\_

Drillers Remarks: \_\_\_\_\_

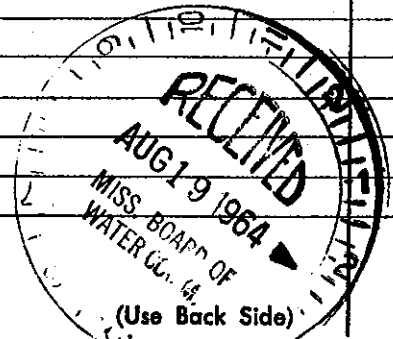

Well No. \_\_\_\_\_

Mail this copy to Board of Water Commissioners 429 Miss. St. Jackson, Miss