

CARROLL MISSISSIPPI BOARD OF WATER COMMISSIONERS

B 43

9-64

WATER WELL DRILLERS LOG

Date: Sept, 1964, Driller: [Signature] County Holmes

(Name)

(1) Owner of Land:	Description & Color of Materials Sand, Clay, Red Clay, Shell, etc.	Thick- ness Feet	Depth Feet
<u>L. L. Rico</u> (Name)	<u>Clay</u>	<u>21</u>	<u>21</u>
<u>Carrollton Miss</u> (Address)	<u>Sand</u>	<u>12</u>	<u>33</u>
(2) Location: <u>NW 1/4, NE 1/4, Sec. 9 T20R3E</u>	<u>Sand - Gravel</u>	<u>29</u>	<u>62</u>
<u>10</u> miles <u>NW</u> of <u>Carrollton</u> (distance) (direction) (Nearest Town)	<u>Sand</u>	<u>6</u>	<u>68</u>
(3) Topography: <u>Hilly</u> (Hilly) (Flat) (Level)	<u>Sand - Gravel</u>	<u>16</u>	<u>84</u>
(4) Purpose of Well: <u>Domestic</u> (Domestic Irrigation Municipal, Industrial, Other)	<u>Sand</u>	<u>42</u>	<u>126</u>


Information upon completion of well:

- (1) Diameter 2 inches.
- (2) Total Depth 126 feet.
- (3) Water Level 87 feet below top of ground.
- (4) Cased to 121, Size 2
- (5) Screen: Size 2", Length 5'
- (6) Were any formations sealed against pollution?
 yes, no.

If YES depth of formation _____

Why _____

Drillers Remarks: _____

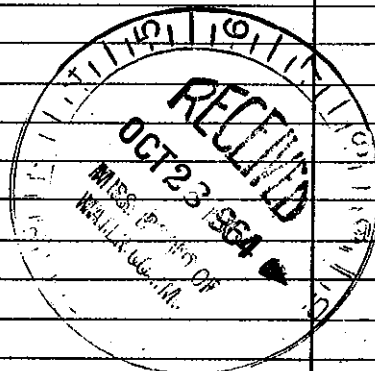

Well No.

(Use Back Side)

Mail this copy to Board of Water Commissioners 429 Miss. St. Jackson, Miss