

CARROLL MISSISSIPPI BOARD OF WATER COMMISSIONERS

B45

WATER WELL DRILLERS LOG

10-12-64

Date: OCT 12, 1964, Drillers: DELTA DRILLING Co, County CARROLL

(Name)

	Description & Color of Materials Sand, Clay, Red Clay, Shell, etc.	Thick- ness Feet	Depth Feet
(1) Owner of Land: <u>S. E BROWN</u> (Name)	CLAY	24	24
<u>RTE. 1, CARROLLTON, MISS</u> (Address)	RED SAND	62	86
(2) Location: <u>SE 1/4, NW 1/4, Sec. 8 T28R3E</u>	GRAVEL	40	126
_____ miles _____ of _____ (distance) (direction) (Nearest Town)	SAND	78	144
(3) Topography: _____ (Hilly) (Flat) (Level)	GRAVEL	12	156
(4) Purpose of Well: <u>DOMESTIC</u> (Domestic Irrigation Municipal, Industrial, Other)	SAND	14	170
	SHALE	18	188
	SAND	20	208
	GUMBO	18	226
	SHALE W/8" ROCK	10	236
	SAND-	12	248

Information upon completion of well:

- (1) Diameter 4 inches.
- (2) Total Depth 302 feet.
- (3) Water Level 200 feet below top of ground.
- (4) Cased to 276, Size 4"
- (5) Screen: Size 2", Length 26'
PERFORATED PIPE
- (6) Were any formations sealed against pollution?
_____ yes, _____ no.


If YES depth of formation _____

Why _____

Drillers Remarks: PUMP SET 231'

WITH 1" PIPE.

DRILLER: DONALD W. WOOD

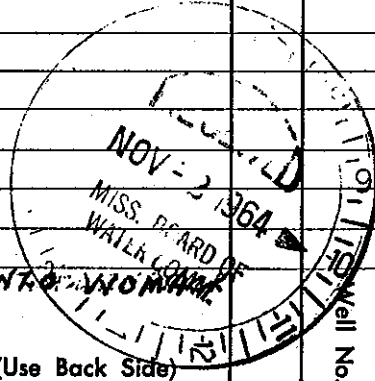

(Use Back Side)

Mail this copy to Board of Water Commissioners 429 Miss. St. Jackson, Miss