

CARROLL MISSISSIPPI BOARD OF WATER COMMISSIONERS

B46
10-63

WATER WELL DRILLERS LOG

Date: Oct, 1963, Driller: Jack Martin County Hale
(Name)

(1) Owner of Land: <u>H. H. Heath</u> (Name)	Description & Color of Materials Sand, Clay, Red Clay, Shell, etc.	Thick- ness Feet	Depth Feet
<u>Carrollton</u> (Address)	<u>Clay</u>	<u>17</u>	<u>17</u>
(2) Location: <u>SE 1/4, NE 1/4, Sec. 25 T20R3E</u>	<u>Sand</u>	<u>123</u>	<u>140</u>
<u>6</u> miles <u>North</u> of <u>Carrollton</u> (distance) (direction) (Nearest Town)			
(3) Topography: <u>Hilly</u> (Hilly) (Flat) (Level)			
(4) Purpose of Well: <u>Domestic</u> (Domestic Irrigation Municipal, Industrial, Other)			


Information upon completion of well:

- (1) Diameter 2 inches.
- (2) Total Depth 140 feet.
- (3) Water Level 95 feet below top of ground.
- (4) Cased to 135, Size 2
- (5) Screen: Size 2", Length 5'
- (6) Were any formations sealed against pollution?
_____ yes, _____ no.

If YES depth of formation _____

Why _____

Drillers Remarks: _____

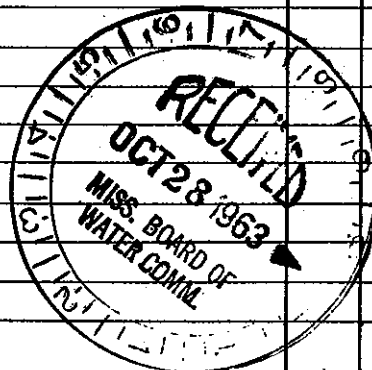

Well No. _____

(Use Back Side)

Mail this copy to Board of Water Commissioners 429 Miss. St. Jackson, Miss.