

CARROLL

B 47

7-62

MISSISSIPPI BOARD OF WATER COMMISSIONERS

WATER WELL DRILLERS LOG

B

Date: July, 1962, Driller: Jack Martin, County: Carroll

(Name)

(1) Owner of Land:	Description & Color of Materials Sand, Clay, Red Clay, Shell, etc.	Thick- ness Feet	Depth Feet
Callie Inman (Name) N Carrollton Miss (Address)	TOP clay	17	17
(2) Location: SW 1/4, NW 1/4, Sec. 36, T.20R.3E	clay - sand	6	23
3 miles NW of Carrollton (distance) (direction) (Nearest Town)	Sand	??	100
(3) Topography: Hilly (Hilly) (Flat) (Level)			
(4) Purpose of Well: Domestic (Domestic Irrigation Municipal, Industrial, Other)			


Information upon completion of well:

- (1) Diameter 2 inches.
- (2) Total Depth 100 feet.
- (3) Water Level 75 feet below top of ground.
- (4) Cased to 95, Size 2"
- (5) Screen: Size 2", Length 57'
- (6) Were any formations sealed against pollution?
_____ yes, _____ no.

If YES depth of formation _____

Why _____

Drillers Remarks: _____

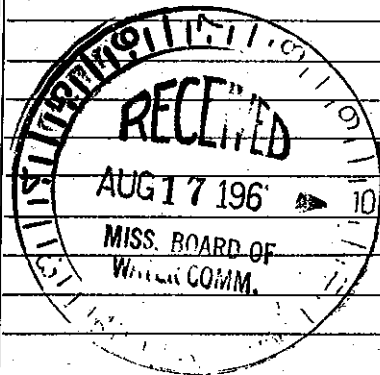

(Use Back Side)

Well No.

Mail this copy to Board of Water Commissioners 429 Miss. St. Jackson, Miss