

Carroll
 BSV
 10-68

MISSISSIPPI
 BOARD OF WATER COMMISSIONERS
 416 North State Street
 Jackson, Mississippi 39201

WATER WELL DRILLERS LOG

OCT 15 1967 date well completed
 DELTA DRILLING CO firm name
 Carroll county well located

LANDOWNER: JESSIE McARDY

RT. 2
 CARROLLTON, MISS.
 (mailing address)

WELL LOCATION: SE 1/4 SE 1/4
 sec. 9 T. 20 N R. 3 E
 X X


_____ miles of _____
 (distance) (direction) (nearest town)

WELL PURPOSE: DOMESTIC
 (home, irrigation, municipal, industrial)

WELL COMPLETION DATA:

- (1) diameter (inches) 4
- (2) total depth (feet) 363
- (3) static water level (feet) 170 below above top of ground.
- (4) casing STEEL 303
 (material) (depth)
4 1/2 If telescope see back.
 (size)
- (5) screen 20' 343
 (length) (depth to top)
2" PERFORATED PIPE
 (size) (material)
- (6) pump 3/4 _____
 (HP) (yield gpm)
ELEC
 (type power)
- (7) electric log NO
 (yes or no)
 (organization running log)
- (8) how well bottom plugged BACK
PRESSURE VALVE

description of formations encountered	from	to
	CLAY	24
Gravel	24	106
Sand	106	185
Clay	185	205
Shale w/rock	205	230
Sand	230	279
Shale w/rock	279	303
Sand	303	363

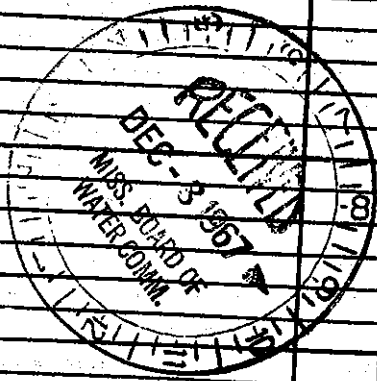

DRILLERS REMARKS: 210'
1" Pump setting