

CARROLL MISSISSIPPI BOARD OF WATER COMMISSIONERS

C 11
6-14-61

WATER WELL DRILLERS LOG

CODED

Date: June 14, 1961, Driller: Robert E. Rattiff County Carroll
(Name)

		Description & Color of Materials Sand, Clay, Red Clay, Shell, etc.	Thick- ness Feet	Depth Feet
(1) Owner of Land:	<u>John T. Chadley</u> (Name)	<u>Shale - sand</u>	<u>15</u>	<u>374</u>
	<u>Carrollton, Miss.</u> (Address)	<u>shale</u>	<u>22</u>	<u>396</u>
(2) Location:	<u>23-21-4</u> 1/4, 1/4, Sec. T. R.	<u>shale</u>	<u>17</u>	<u>410</u>
	<u>15</u> miles <u>South West</u> of <u>GRENADA</u> (distance) (direction) (Nearest Town)	<u>sand</u>	<u>8</u>	<u>418</u>
		<u>sand</u>	<u>21</u>	<u>439</u>
(3) Topography:	<u>hilly</u> (Hilly) (Flat) (Level)			
(4) Purpose of Well:	<u>Domestic</u> (Domestic Irrigation Municipal, Industrial, Other)			

Information upon completion of well:


- (1) Diameter 4x2 inches.
- (2) Total Depth 439 feet.
- (3) Water Level 213 feet below top of ground.
- (4) Cased to total depth Size 4x2.
- (5) Screen: Size 2", Length 10ft.
- (6) Were any formations sealed against pollution?
✓ yes, _____ no.

If YES depth of formation cased

Why _____

Drillers Remarks: well pumped
10 bpm w/air

CODED

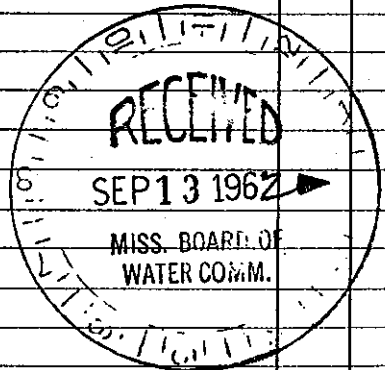

Well No.

(Use Back Side)

Mail this copy to Board of Water Commissioners 429 Miss. St. Jackson, Miss.