

CARROLL MISSISSIPPI BOARD OF WATER COMMISSIONERS

C 23

3-66

WATER WELL DRILLERS LOG CODED

Date: March, 19 66, Driller: Jack Martin County Holmes
(Name)

| (1) Owner of Land: <u>Bobby Cassidy</u> <small>(Name)</small> | Description & Color of Materials Sand, Clay, Red Clay, Shell, etc. | Thick- ness Feet | Depth Feet |
|---|---|------------------------|---------------|
| <u>McCarley</u> <small>(Address)</small> | <u>Clay</u> | <u>12</u> | <u>12</u> |
| (2) Location: <u>NE 1/4, NE 1/4, Sec. 22 T20R4E</u> | <u>Sand layers</u> | <u>58</u> | <u>70</u> |
| <u>5 1/2</u> miles <u>NE</u> , of <u>Cassellton</u> <small>(distance) (direction) (Nearest Town)</small> | <u>Sand - Mud layers</u> | <u>15</u> | <u>85</u> |
| (3) Topography: <u>Hilly</u> <small>(Hilly) (Flat) (Level)</small> | <u>Sand</u> | <u>63</u> | <u>148</u> |
| (4) Purpose of Well: <u>Domestic</u> <small>(Domestic Irrigation Municipal, Industrial, Other)</small> | | | |


Information upon completion of well:

- (1) Diameter 4 inches.
- (2) Total Depth 148 feet.
- (3) Water Level 82 feet below top of ground.
- (4) Cased to 138, Size 4.
- (5) Screen: Size 2, Length 10.
- (6) Were any formations sealed against pollution?
 yes, no.

If YES depth of formation _____

Why _____

Drillers Remarks: _____

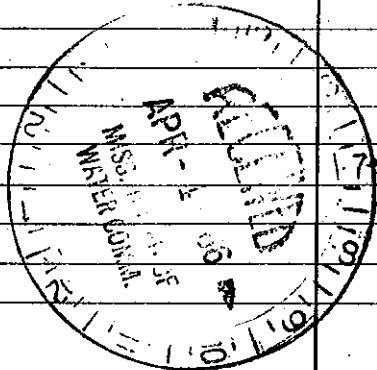

(Use Back Side)

Well No.

Mail this copy to Board of Water Commissioners 429 Miss. St. Jackson, Miss