

CARROLL

C 26

3-68

MISSISSIPPI
 BOARD OF WATER COMMISSIONERS
 416 North State Street
 Jackson, Mississippi 39201

CODED

WATER WELL DRILLERS LOG

3-7-68

Butane Gas Co. of Greenwood

CARROLL

date well completed

firm name

county well located

LANDOWNER:

G. DAN Thompson

description of formations encountered

from to

CARROLLTON, Miss.
(mailing address)

CLAY	0	14
SAND + CLAY	14	21
SANDY CLAY	21	33
SHALE	33	87
SAND + CLAY	87	121
CLAY	121	129
SHALE + ROCK	129	185
SAND	185	213
SANDY SHALE	213	241
ROCK	241	

WELL LOCATION:


sec. 31 T. 21 N R. 4 E
 9 miles N of N. CARROLLTON
 (distance) (direction) (nearest town)

WELL PURPOSE:

Home (home, irrigation, municipal, industrial)

WELL COMPLETION DATA:

- (1) diameter (inches) 4 3/4
- (2) total depth (feet) 241
- (3) static water level (feet) 146 below above top of ground.
- (4) casing Steel, 193 (material), (depth)
4 X 2" (size) If telescope see back.
- (5) screen 20', 193 (length), (depth to top)
2, stainless steel (size), (material)
- (6) pump 1, 8 (HP), (yield gpm)
Elec. (type power)
- (7) electric log NO (yes or no)
 (organization running log)
- (8) how well bottom plugged
Basic Pressure Valve

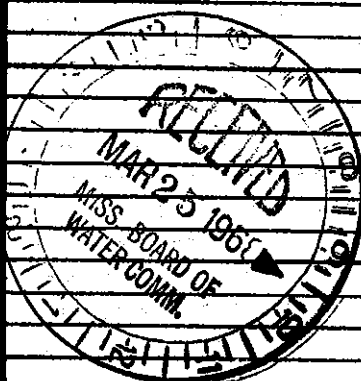

DRILLERS REMARKS: