


Carroll WATER WELL DRILLERS LOG

Date: DEC 12, 1966, Driller: DELTA DRILLING Co. County CARROLL
 (Name)

	Description & Color of Materials Sand, Clay, Red Clay, Shell, etc.	Thick- ness Feet	Depth Feet
(1) Owner of Land: <u>CECIL BROWNING</u> (Name)	Sand	19	19
<u>Rt. 1, Box 264 E. GREENWOOD</u> (Address)	gumbo	21	40
(2) Location: <u>NW 1/4, SW 1/4, Sec. 15 T. 19 N. R. 2 E.</u>	Sand	20	60
<u>5</u> miles <u>E</u> of <u>G'wood</u> (distance) (direction) (Nearest Town)	gravel	64	124
(3) Topography: <u>FLAT</u> (Hilly) (Flat) (Level)	Sand	21	145
(4) Purpose of Well: <u>DOMESTIC</u> (Domestic Irrigation, Municipal, Industrial, Other)	gravel	20	165
Information upon completion of well:	green sand	44	209
(1) Diameter: <u>4</u> inches.	Shale	36	245
(2) Total Depth: <u>468</u> feet.	Sand w/rocks	40	285
(3) Water Level: <u>FLOWS</u> feet below top of ground.	Shale w/rocks	45	330
(4) Cased to: <u>393</u> , Size: <u>2" 393</u>	Sand	10	340
(5) Screen: Size: <u>2"</u> , Length: <u>25'</u> <u>PERFORATED PIPE</u>	Shale	68	408
(6) Were any formations sealed against pollution?	SAND	60	468
<input checked="" type="checkbox"/> yes, <input type="checkbox"/> no.			
If YES depth of formation: <u>75'</u>			
Why:			
Drillers Remarks: <u>75NI-5GB-RED</u>			
<u>JACKET SUBMERSIBLE PUMP</u>			
<u>INSTALLED IN WELL.</u>			

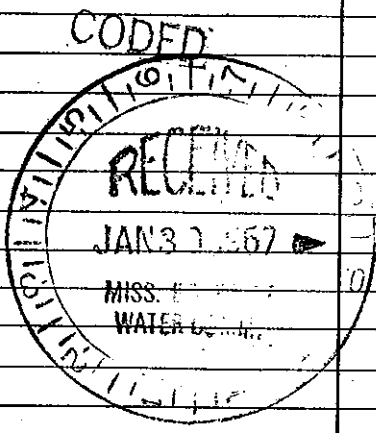

DRILLER: ROBERT WEATHERS

Well No.

(Use Back Side)

Retain this copy for your office files.