

Carroll  
D3

MISSISSIPPI BOARD OF WATER COMMISSIONERS

ELOG # 30

11-66

WATER WELL DRILLERS LOG

CODED

Date: NOV. 2, 1966, Drillers: DELTA DRILLING Co. County: CARROLL

E Log #30

(Name)

GREENWOOD LEFLORA

(1) Owner of Land: AIRPORT BOARD

(Name)

GREENWOOD, MISS.

(Address)

(2) Location: SE 1/4, SE 1/4, Sec. 21 T19R2E

\_\_\_\_\_ miles \_\_\_\_\_ of \_\_\_\_\_  
(distance) (direction) (Nearest Town)

(3) Topography: FLAT

(Hilly) (Flat) (Level)

(4) Purpose of Well: MUNICIPAL

(Domestic Irrigation  
Municipal, Industrial, Other)

Description & Color of Materials Sand, Clay, Red Clay, Shell, etc.	Thick- ness Feet	Depth Feet
SAND	30	30
Shale	22	52
Sand	34	86
gravel	40	126
Gumbo	33	159
green shale w/rocks	32	191
green sand	20	211
Shale	10	221
green sand w/rocks	52	273
Shale	38	311
green sand w/rock	28	339
Shale	18	357
Sand	11	368
green shale	40	408
green sand	108	516
Shale	20	536
Sand	12	548
Shale	16	564
Sand	38	602
Shale	40	642
Sand	50	692
Shale	28	720
		28
		692

Information upon completion of well:

(1) Diameter: 4 inches.

692

(2) Total Depth: 720 feet.

(3) Water Level: WELL FLOWS feet below top of ground.

672 4"-400'

(4) Cased to: 692', Size: 2 1/2" 3 15'

(5) Screen: Size: 2 1/2", Length: 20

(6) Were any formations sealed against pollution?

yes,  no.


If YES depth of formation: 400'

Why: \_\_\_\_\_

Drillers Remarks: 15' LAP OF 2 1/2"

IN 4" PIPE = 28' - 2 1/2"

TAIL PIPE.

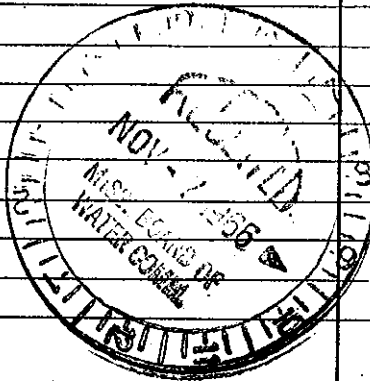

(Use Back Side)

Well No.

Mail this copy to Board of Water Commissioners 429 Miss. St. Jackson, Miss