

Carroll
D 24
12-66

MISSISSIPPI BOARD OF WATER COMMISSIONERS

WATER WELL DRILLERS LOG

CODED

Date: DEC 12, 1966, Driller: DELTA DRILLING Co. County CARROLL
(Name)

(1) Owner of Land: CECIL BROWNING
(Name)
RT. 1, BOX 264-B, GREENWOOD
(Address)
(2) Location: NW 1/4, SW 1/4, Sec. 15 T19R2E
4 1/2 miles EAST of GREENWOOD
(distance) (direction) (Nearest Town)
(3) Topography: FLAT
(Hilly) (Flat) (Level)
(4) Purpose of Well: DOMESTIC
(Domestic Irrigation
Municipal, Industrial, Other)

Description & Color of Materials Sand, Clay, Red Clay, Shell, etc.	Thick- ness Feet	Depth Feet
Sand	19	19
gumbo	21	40
Sand	20	60
gravel	64	124
Sand	21	145
gravel	20	165
green sand	44	209
Shale	36	245
Sand w/ROCKS-	40	285
Shale w/ROCKS-	45	330
Sand	10	340
Shale	68	408
SAND	60	468

Information upon completion of well:

(1) Diameter 4 inches.
(2) Total Depth 468 feet.
(3) Water Level FLOWS feet below top of ground.
4" 75'
(4) Cased to 393, Size 2" 393'
(5) Screen: Size 2", Length 25'
(6) Were any formations sealed against pollution?
✓ yes, _____ no.


If YES depth of formation 75'

Why _____

Drillers Remarks: 75N1-5CB-RED

JACKET SUBMERSIBLE PUMP

INSTALLED IN WELL.

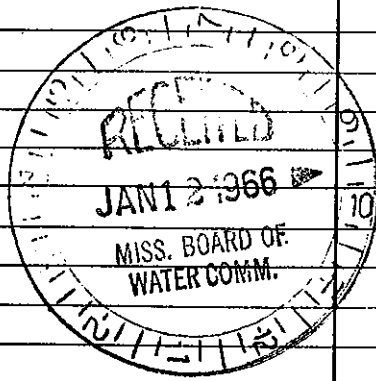

CODED

CODED

Well No.

(Use Back Side)

Mail this copy to Board of Water Commissioners 429 Miss. St. Jackson, Miss