

CODED

MISSISSIPPI
BOARD OF WATER COMMISSIONERS
416 North State Street
Jackson, Mississippi 39201

WATER WELL DRILLERS LOG

Carroll
D25
9-67

SEPT 8 1967 date well completed
DELTA DRILLING Co. firm name
CARROLL county well located

LANDOWNER: JIMMIE BLOUNT

R.T. 3

CARROLLTON, MISS
(mailing address)

WELL LOCATION: SE 1/4 NE 1/4
sec. 35 T 19 N R 2 E
X X

miles of (distance) (direction) (nearest town)

WELL PURPOSE: DOMESTIC
(home, irrigation, municipal, industrial)


WELL COMPLETION DATA:

- (1) diameter (inches) 2
- (2) total depth (feet) 224
- (3) static water level (feet) 175 below above top of ground.
- (4) casing STEEL, 200 (material) (depth)
2 (size) if telescope see back.
- (5) screen 10' 200 (length) (depth to top)
2" 5 STEEL (size) (material)
- (6) pump 1/2 (HP) (yield gpm)
ELEC (type power)
- (7) electric log No (yes or no)
(organization running log)
- (8) how well bottom plugged BACK PRESSURE

description of formations encountered

from to

Red sand	0	43
gravel	43	104
Sand	104	120
gravel	120	128
RED Sand	128	144
Sand	144	220
Gumbo	220	224

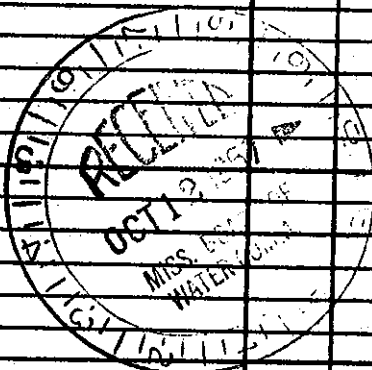

DRILLERS REMARKS: WELL SET
210' - 196' - PUMP SETTING