

CODED

MISSISSIPPI
BOARD OF WATER COMMISSIONERS
416 North State Street
Jackson, Mississippi 39201

WATER WELL DRILLERS LOG

CARROLL
D 27
3-68


3.20 1968 Jack Martin Carroll
date well completed firm name county well located

LANDOWNER:	description of formations encountered	from	to
Rt 1 Box 213A			
Greenwood (mailing address)	Sand	25	62
WELL LOCATION:	Sand + Gravel	62	81
sec. 36 T. 19 N R. 2 E #	Sand	81	152
8 miles SW of Carrollton (distance) (direction) (nearest town)			
WELL PURPOSE: Home (home, irrigation, municipal, industrial)			

- WELL COMPLETION DATA:
- (1) diameter (inches) 2
 - (2) total depth (feet) 152
 - (3) static water level (feet) 123 below top of ground.
 - (4) casing Steel 147
(material) (depth)
2 (size) if telescope see back.
 - (5) screen 5 147
(length) (depth to top)
2 Stainless Steel
(size) (material)
 - (6) pump 3/4 3
(HP) (yield gpm)
Elec
(type power)
 - (7) electric log 7/6
(yes or no)
(organization running log)
 - (8) how well bottom plugged Cas

CODED

CODED

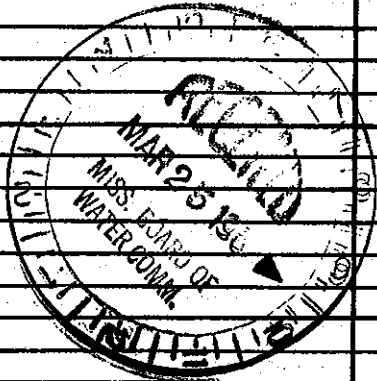

DRILLERS REMARKS: