County: Carroll				
Permit#: Irrigation Driller:	Equipment			
Date drilling completed:	3-15-06			

State Well Report

Part 1

Mississippi Department of Environmental Quality Office of Land and Water Resources P.O. Box 10631 Jackson, MS 39289-0631 (601)961-5210 (601)354-6938 (fax)

For Office	Use Only:
Aquifer:	
Well #:	70
L. S. Elevation:	
E-log #:	

State Law requires that this report be prepared by the driller in detail and filed with the Department within

30 days of completion of drilling of the well.	at their in decan one med med and one peparement when	
Well Owner Information	Well Location	
Owner Name Harry Lott	33 30 28.5 90 04 09.6W Latitude: Longitude: Conventional Survey,	
Mailing Address: 704 Robert E Lee Drive	Method of Lat/Long (circle one): Conventional Survey,	
	USGS quad, Hand-held GPS, Survey-grade GPS	
	NE ₄ SE ½ Sec 15 Twn 19N Rng 2E	
Greenwood MS 38930	NB/4 SE 1/4 Sec 13 Twn 1910 Rng 2E	
City State Zip Code	Distance Direction Nearest Town	
Telephone No. (8 Miles West of Carrollton	
Well 1	Data	
Purpose of Well (circle one) Home Industrial Public Supply	Arrigation Fish Culture Other:	
Date well drilling started: 3-15-06 Date v		
Date well drilling started:	well drilling completed:	
If flowing, method of flow regulation: Valve Other (d	escribe)	
Static Water Level: 10' feet above or below (circle one)!	and surface Date measured: 3-16-06	
Method of Measurement (circle one) seel tape electric tape	air line other:	
Hole depth: 115 Well depth: 115'	Well grouted to a depth of 10 feet	
Type of grout (circle one): Cement Bentonite Mix		
Casing length: 75 feet Casing diameter: 10	inches Type of casing:PVC	
Screen length: 40 feet Screen diameter: 10	inches Type of screen: PVC	
Screen slot size:inches Setting depth: From _		
Type of completion (circle all applicable): Gravel packed Under	rreamed Telescoped Open hole Natural Development	
Other (describe):		
Top of lap pipe or reduction in casing:feet. If te	descoped or more than one screen, describe on back of page	
Logs run (circle all applicable); ho log run Electric Gamma Ray	Density Sonic Neutron Other:	
Name of organization running log(s):		
I certify that the well was drilled, constructed, and completed in accordance with all applicable requirements of the Mississippi		
Department of Environmental Quality and/or the Mississippi De	partment of Health regulations and state laws.	
Irrigation Equipment Inc. Patrick M. Chism 0695	Patro M Chr	
Print Name of Water Well Contractor and License No.	Signature of Water Well Contractor	

RECEIVED


MAR 27 2006

BY: OLWS

Ground Level

Description of Formations Encountered	From	То
Clav	0	4
Fine Sand	5	22
Clay	23	65
Fine Sand/gravel	66	72
Med. Sand/gravel	73	77
Fine Sand/gravel Med. Sand/gravel	78	82
Med. Sand/gravel	83	105
Fine Sand/gravel	106	115
	 	
5.6.0.	 	
.032 Screen 76-85		\vdash
.050 Screen 86-105	 	\vdash \dashv
.032 Screen 106-115	-	
	 	\vdash
	├	\vdash
	-	\vdash
	 	\vdash
	 	
	 	$\vdash \vdash$
	 	\vdash
	+	$\vdash \dashv$
	 	$\vdash \vdash \vdash$
	ــــــــــــــــــــــــــــــــــــــ	

If more than one screen, show location of each on sketch

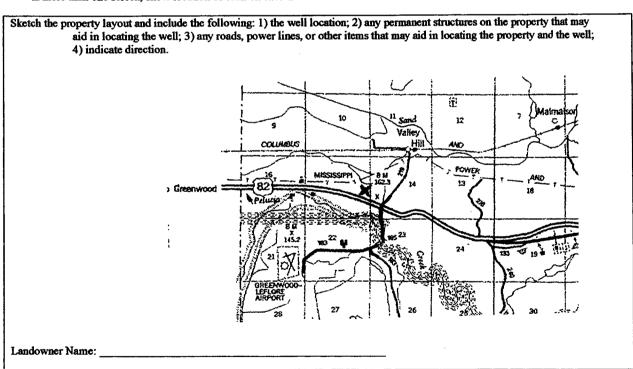

Signature of Water Well Contractor

STATE WELL REPORT

County: Carroll P Mississ Drille: Irrigation Equipment

Part 2
Pump Installer's Completion Report
Mississippi Department of Environmental Quality
Office of Land and Water Resources
P.O. Box 10631
Jackson, MS 39289-0631

For Office Use Only:	
Aquifer:	
Well #:	D-70

Date completed: 3-	15-06		1)961-5210 54-6938 (fax) Elevation:
This report shou installation of pu		by the pump installer in det	tail and filed with the Department within 30 days of the
V	Vell Owner Info	rmation	Well Location
Owner Name: Ha	rry Lott		Latitude:Longitude:
Mailing Address: 70	4 Robert	E Lee Drive	Method of Lat/Long (circle one): Conventional Survey,
			USGS quad, Hand-held GPS, Survey-grade GPS
	eenwood	MS 38930	¼¼ Sec 15 Twn 19N Rng 2E
City	y St	ate Zip Code	Distance Direction Nearest Town
Telephone No. (62-453-28)	367	8 Miles West of Carrollton
	Ритр Тур	e	Power Type
	Circle one		Circle one
Air Lift	Jet	Submersible	Diesel Engine Gasoline Engine Natural Gas
Bucket	Piston	Turbine	Hand Tractor PTO
Centrifugal	Rotary	Flowing Well	Windmill Other (specify):
Other (specify):	 		Horse Power Rating of Motor: 25
Date Pump Installed:	3-16	-06	Setting Depth: 70 feet
Rated Pump Capacity:	: 1100	Gallons Per Minute	Number of Stages:
	Pump Test D	Pata	Method of Measuring Water Level Circle one
Date Well Tested:			Circle one
		Feet Below Land Surface	Air Line Electric Measuring Line Steel Tape
Pumping Water Level	(B):	Feet Below Land Surface	Other (specify):
		Feet Below Land Surface	For flowing well, measured shut in head:feet
Test Pumping Rate: _		Gallons Per Minute	Well yieldedGPM with a drawdown of
Duration of Pump Tes	st (minimum 4 ho	ours):hours	feet afterhours of pumping
Patrick M	. Chism	tatements are true to the best 0695 nse No. (if applicable)	of my knowledge. And M Consider Signature of Pump Installer

RECEIVEL