

State Well Report

Part 1

Mississippi Department of Environmental Quality
Office of Land and Water Resources
P.O. Box 10631
Jackson, MS 39289-0631
(601)961-5210
(601)354-6938 (fax)

For Office Use Only:

Aquifer: _____
Well #: D-73
L. S. Elevation: _____
E-log #: _____

County: Carroll
Permit #: GW42561
Driller: Irrigation Equipment
Date drilling completed: 6-9-08

State Law requires that this report be prepared by the driller in detail and filed with the Department within 30 days of completion of drilling of the well.

Well Owner Information	Well Location
Owner Name: <u>Montgomery Farms</u>	Latitude: <u>33° 32' 21.8"</u> Longitude: <u>90° 04' 39.6"</u>
Mailing Address: <u>215 County Rd. 186</u>	Method of Lat/Long (circle one): <u>22</u> Conventional Survey, <u>39</u>
<u>Greenwood Ms. 38930</u>	USGS quad, Hand-held GPS, Survey-grade GPS
City State Zip Code	<u>SE 1/4 NW 1/4 Sec 3 Twn 19N Rng 2E</u>
Telephone No. () _____	Distance Direction Nearest Town
	<u>3 Miles SW of Teoc</u>

Well Data

Purpose of Well (circle one) Home Industrial Public Supply Irrigation Fish Culture Other: _____

Date well drilling started: 6-9-08 Date well drilling completed: 6-9-08

If flowing, method of flow regulation: Valve _____ Other (describe) _____

Static Water Level: 11 feet above or below (circle one) land surface Date measured: 6-9-08

Method of Measurement (circle one) steel tape electric tape air line other: _____

Hole depth: 105 Well depth: 105 Well grouted to a depth of 10 feet

Type of grout (circle one): Cement Bentonite Mix

Casing length: 65 feet Casing diameter: 16 inches Type of casing: PVC

Screen length: 40 feet Screen diameter: 16 inches Type of screen: PVC

Screen slot size: .050 inches Setting depth: From see back feet to _____ feet

Type of completion (circle all applicable): Gravel packed Underreamed Telescoped Open hole Natural Development

Other (describe): _____

Top of lap pipe or reduction in casing: _____ feet If telescoped or more than one screen, describe on back of page

Logs run (circle all applicable): No log run Electric Gamma Ray Density Sonic Neutron Other: _____

Name of organization running log(s): _____

I certify that the well was drilled, constructed, and completed in accordance with all applicable requirements of the Mississippi Department of Environmental Quality and/or the Mississippi Department of Health regulations and state laws.

Irrigation Equipment Inc
Patrick M. Chism 0695

Print Name of Water Well Contractor and License No. _____ Signature of Water Well Contractor Patrick M. Chism

RECEIVED
JUN 13 2008
BY: OLWR

If well telescopes please sketch below and show depths.

Ground Level

Description of Formations Encountered	From	To
Clay	0	18
Fine Sand + Clay	19	27
Clay	28	41
Fine Sand	42	49
Fine Sand + Gravel	50	57
Medium Sand + Gravel	58	84
Fine Sand	85	89
Medium Sand + Gravel	90	100
Clay	101	105
Screen .050		
(61 - 85) 25'		
(91 - 105) 15'		

- Blanked 4'

If more than one screen, show location of each on sketch

Sketch the property layout and include the following: 1) the well location; 2) any permanent structures on the property that may aid in locating the well; 3) any roads, power lines, or other items that may aid in locating the property and the well; 4) indicate direction.

Landowner Name: Montgomery Farms

Pat
 Signature of Water Well Contractor

RECEIVED
 JUN 13 2008
 BY: OLWR

STATE WELL REPORT

Part 2

Pump Installer's Completion Report
 Mississippi Department of Environmental Quality
 Office of Land and Water Resources
 P.O. Box 10631
 Jackson, MS 39289-0631
 (601)961-5210
 (601)354-6938 (fax)

County: Carroll
 Permit #: _____
 Irrigation Equipment
 Driller: _____
 Date completed: 6-9-08

For Office Use Only:

Aquifer: _____
 Well #: D-73
 Elevation: _____

This report should be prepared by the pump installer in detail and filed with the Department within 30 days of the installation of pump.

Well Owner Information	Well Location
Owner Name: <u>Montgomery Farms</u> Mailing Address: <u>215 County Rd. 186</u> <u>Greenwood</u> <u>Ms.</u> <u>38930</u> <small>City State Zip Code</small> Telephone No. () _____	Latitude: _____ Longitude: _____ Method of Lat/Long (circle one): Conventional Survey, USGS quad, Hand-held GPS, Survey-grade GPS <u>SE</u> $\frac{1}{4}$ <u>NW</u> $\frac{1}{4}$ Sec <u>3</u> Twn <u>19N</u> Rng <u>2E</u> Distance Direction Nearest Town <u>3</u> Miles <u>SW</u> of <u>Teoc</u>

Pump Type Circle one	Power Type Circle one
Air Lift Jet Submersible Bucket Piston Turbine Centrifugal Rotary Flowing Well Other (specify): _____ Date Pump Installed: <u>6-9-08</u> Rated Pump Capacity: <u>2300[±]</u> Gallons Per Minute	Diesel Engine Gasoline Engine Natural Gas Electric Motor Hand Tractor PTO Windmill Other (specify): _____ Horse Power Rating of Motor: <u>60</u> Setting Depth: <u>70</u> feet Number of Stages: <u>2</u>

Pump Test Data	Method of Measuring Water Level Circle one
Date Well Tested: _____ Static Water Level (A): _____ Feet Below Land Surface Pumping Water Level (B): _____ Feet Below Land Surface Drawdown [(B) - (A)]: _____ Feet Below Land Surface Test Pumping Rate: _____ Gallons Per Minute Duration of Pump Test (minimum 4 hours): _____ hours	Air Line Electric Measuring Line Steel Tape Other (specify): _____ For flowing well, measured shut in head: _____ feet Well yielded _____ GPM with a drawdown of _____ feet after _____ hours of pumping

I HEREBY CERTIFY that the above statements are true to the best of my knowledge.

Patrick M. Chism 0695
 Print Name of Pump Installer and License No. (if applicable) Signature of Pump Installer

RECEIVED

JUN 13 2008
 BY: OLWR

Montgomery Farms Map

720 000 m

730 000 m

1


90° 05'

90° 00'

2

89° 55'

D-73

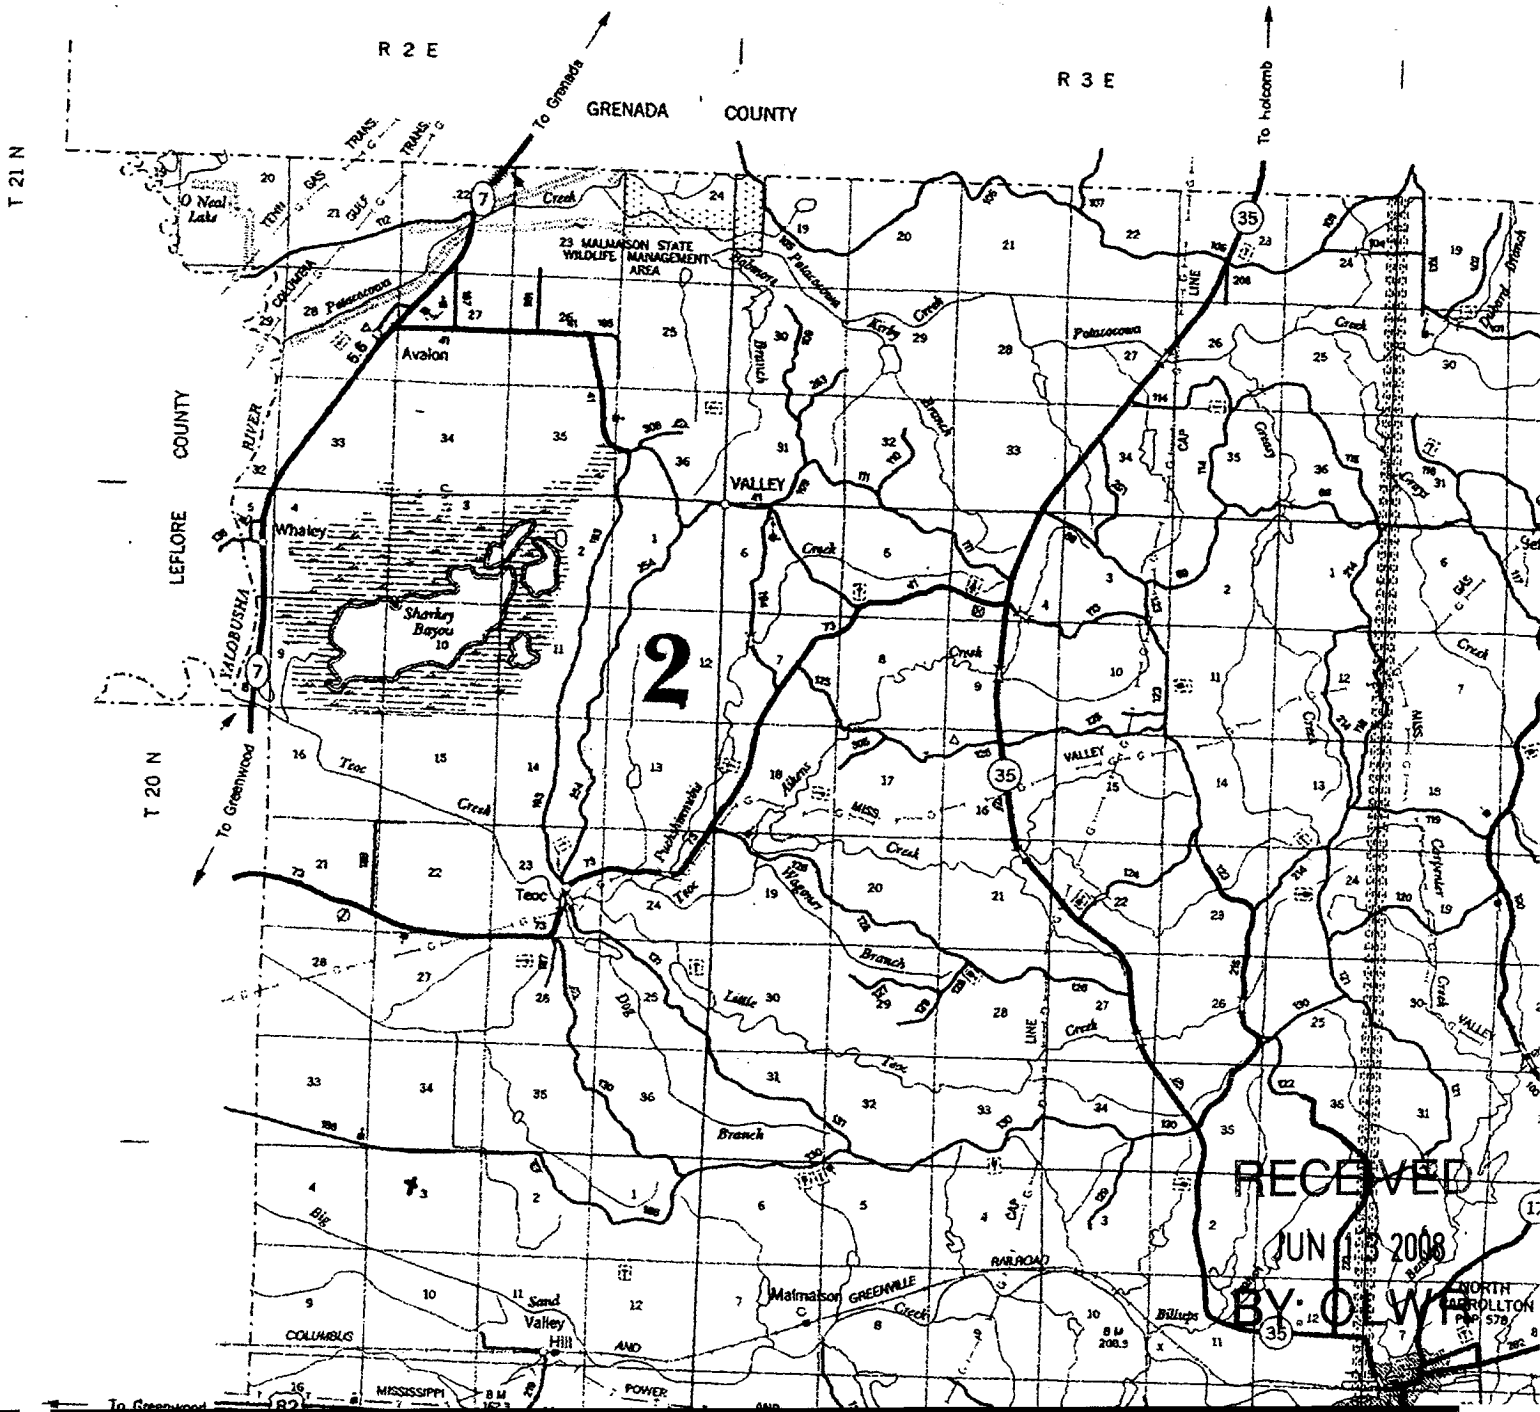

RECEIVED

JUN 13 2008

BY O. W. ...

NORTH CARROLLTON
MAP 578