	State Well Report
County: Leflore Carroll	Part 1 – Driller's Log
	Mississippi Department of Environmental Quality
	Office of Land and Water Resources
Driller: Irrigation Equipment	P.O. Box 2309
Date drilling completed: 05/17/2012	Jackson, MS 39225
Date drining completed.	(601) 961-5210
	(601) 961-5228 (fax)

• •

For Office Use Only:			
Aquifer:	D-204		
Well #:	D18		
L.S. Eleva	ation:		
E-log #:			

State Law requires that this report be prepared by the license holder responsible for the work and filed with the Department at the above address within 30 days of completion of drilling of the well or borehole.

Information on Well Owner	Well or Borehole Location
(Landowner if borehole is not for a water well)	
Owner Name William Dunn Farms II	Latitude: $33 \circ 32 ' 19$ " Longitude: $90 \circ 06 ' 02$ '
Mailing Address: 1201 Riverbend Drive	Method of Lat/Long (check one):
	USGS quad, Mand-held GPS, Survey-grade GPS
Greenwood Ms 38930	<u>SE ¼ NE ¼ Sec 4</u> Twn <u>19N</u> Rng <u>2E</u>
City State Zip code	Distance Direction Nearest Town
Telephone No	<u>2</u> Miles <u>Northeast</u> of <u>Greenwood</u>
Well / B	orehole Data
Date drilling started: 05/17/2012 Date drilling completed: 05/	17/2012 Hole depth: 93 Hole diameter: 18"
Location of the source of any surface water used for drilling: <b>Surface</b> Method of dosing and volume of Chlorine used in drilling and developm	
Logs run (check all applicable): 🛛 No log run 🗍 Electric 🗋 Gamm Name of organization running log(s):	a Ray Density Sonic Neutron Other:
Purpose of borehole (check one): 🛛 Water Well 🔲 Geotechnica	l/Geological Investigation Ground Source Heat Pump
Seismic Survey Other (	describe)
If drilling is not related to water well co	onstruction, skip the remainder of this block
Purpose of Well (check one) 🔲 Home 📋 Industrial 📄 Public Su	pply 🛛 Irrigation 📋 Fish Culture 🔲 Other:
If flowing, method of flow regulation: Valve Other (de	escribe)
Static Water Level: <u>14</u> feet above or below (check one) $\Box$ la	nd 🖾 surface Date measured: 05/18/2012
Method of Measurement (check one) 🖾 steel tape 🗌 electric tape	air line other:
Well depth: <u>93</u> Well grouted to a depth of <u>10</u> feet	Type of grout (check one): 🗌 Neat Cement 🖾 Bentonite 🗌 Mix
Casing length: <u>57.54</u> feet Casing diameter: <u>10</u>	inches Type of casing: PVC
Screen length: <u>36</u> feet Screen diameter: <u>10</u>	inches Type of screen: <b>PVC</b>
Screen slot size:050 inches Setting depth: From	<b>55</b> 54 feet to <b>90</b> feet
Type of completion (check all applicable): Gravel packed	Underreamed Telescoped Open hole Natural Development
Other (describe):	
Top of lap pipe or reduction in casing: feet. ]	f telescoped or more than one screen, describe on next page
	Form: OLWR-SWR-1A (04/08
	<u>此</u> 月 27 礼 说

## The sketch below only required for water wells

If well telescopes, show depths on sketch.

Ground level

۱

•

,



0204

JUI 27 2012

D78

Description of Formations Encountered	From (depth)	To (depth
Clay	Ground level	38
Fine Sand	39	49
Fine Sand & Gravel	50	52
Medium Sand & Gravel	53	89
Fine Sand	90	93
Blanked 3' on bottom		
· · · · · · · · · · · · · · · · · · ·		
		· · ·

If more than one screen, show location of each on sketch

Sketch the property layout and include the following aid in locating the well; 3) any roads 4) a north arrow.			
Landowner Name: William Dunn Farms II			
I certify that the well/borehole was drilled, constructed,	and completed in accordance	with all applicable requirem	Form: OLWR-SWR-1A (04/08)
Mississippi Department of Environmental Quality and			
laws.			
Patrick Chism 0695	07/19/2012	1000	والمراجع وال
Print Name of Responsible Licensee and License No.	Date	Signature of Licensee	FEC -

A204

## STATE WELL REPORT

County:	<u>Leflore</u>	Carroll	
Permit #:	GW-4592	28	
Driller:	Irrigation	Equipment	
Date drilling completed: 05/17/2012			
Copy information from block on Part 1			

.

## Part 2 Pump Installer's Completion Report


Mississippi Department of Environmental Quality Office of Land and Water Resources P.O. Box 2309 Jackson, MS 39225 (601) 961-5210 (601) 961-5228 (fax)

	For Office Use Only:
Aquifer:	<u></u>
Well #:	D78
Elevation:	

This part of the report must be completed by a licensed water well contractor or a licensed pump installer. A copy of Part 1 of the report must be attached and both parts filed with the Department at the above address within 30 days of well completion.

Well Owner Information		Well Location		
Owner Name: <u>V</u>	William Dunn Farms II	[	Latitude: 33 32' 19.5 N Longitude: 90 (	06' 02.2 W
Mailing Address: 1201 Riverbend Drive		Method of Lat/Long (check one): Conventional Survey,		
			🗌 USGS quad, 🛛 Hand-held GPS, 📋 S	Survey-grade GPS
	Greenwood	Ms 38930	<u>SE ¼ NE ¼ Sec 4</u> T <u>19N</u>	R <u>2E</u>
	City	State Zip code	Distance Direction Nearest Tow	'n
Telephone No.	() -		2 Miles Northeast of Greenwood	<u>d</u>
Pump Type Check one		Power Type Check one		
🗌 Air Lift	🔲 Jet	Submersible	Diesel Engine Gasoline Engine	Natural Gas
Bucket	Piston	Turbine	Electric Motor	Tractor PTO
Centrifugal	Rotary	Flowing Well	Windmill Other (specify):	
Other (specify):	· · · · · · · · · · · · · · · · · · ·		Horse Power Rating of Motor: 15	
Date Pump Installed: 05/18/2012		Setting Depth: 60	feet	
Rated Pump Capa	city _ <b>550+/-</b>	Gallons Per Minute	Number of Stages: 1	<del></del>
Pump Test Data		Method of Measuring Water Level Check one		
Date Well Tested:			Air Line Electric Measuring Line	Steel Tape
Static Water Level	l (A):	Feet Below Land Surface	Other (specify):	
Pumping Water Le	evel (B):	Feet Below Land Surface		
Drawdown [(B) -	(A)]:	Feet Below Land Surface	For flowing well, measured shut in head:	feet
Test Pumping Rate	e:	Gallons Per Minute	Well yielded GPM v	with a drawdown of
Duration of Pump	Test (minimum 4 hours):	hours	feet after	_ hours of pumping
This is for (c	check one): 🛛 Nev	v Well Replacen	ment of Existing Pump Repair of Existing Pump	
	I HEREBY CERTIFY that the above statements are true to the best of my knowledge.			
Patrick Chisn Print Name of P	ump Installer and License	0695 No. (if applicable)	Signature of Pump Installer	.IUI 27 7.12
L	<u> </u>		Form: (	OLWR-SWR-1C (07-09)
Frank second dead by Fr				

D78 Dat +

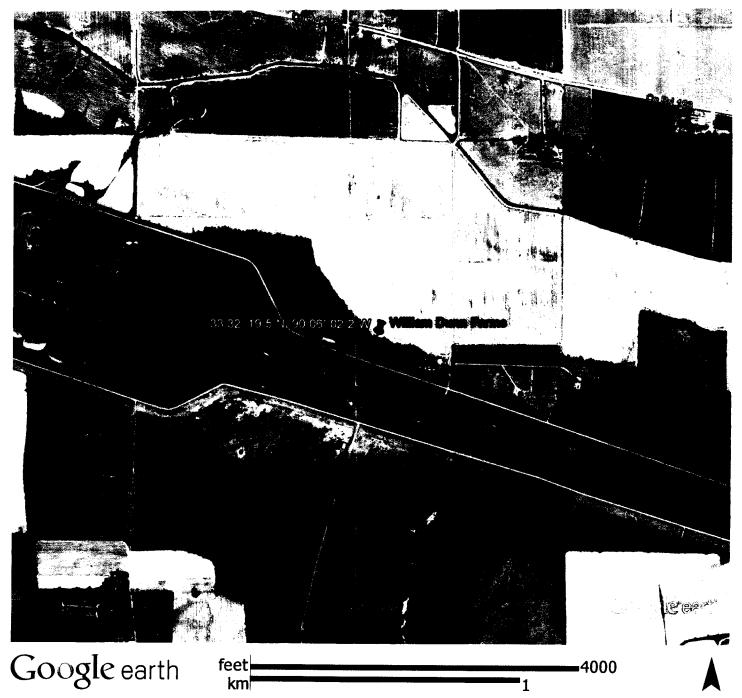

DECE ID JUL 22 J. R