

CODED

E1007# 36

Carroll  
E 11  
8-68

MISSISSIPPI  
BOARD OF WATER COMMISSIONERS  
416 North State Street  
Jackson, Mississippi 39201

WATER WELL DRILLERS LOG

Aug. 19, 1968 DELTA DRILLING Co CARROLL  
date well completed firm name county well located

LANDOWNER: E.C. BRYANT  
GREENWOOD, MISS.

600 PARSONS  
(mailing address)

WELL LOCATION: NW 1/4 NW 1/4 SW 1/4  
sec. 19 T. 19 N R. 3 E W

(distance) miles (direction) of (nearest town)


WELL PURPOSE: DOMESTIC  
(home, irrigation, municipal, industrial)

WELL COMPLETION DATA:

- (1) diameter (inches) 4"
- (2) total depth (feet) 535
- (3) static water level (feet) 140 below above top of ground.
- (4) casing STEEL 49.5' (material) (depth)  
4+2 1/2" if telescope see back. (size)
- (5) screen 25' 49.5' (length) (depth to top)  
2 1/2" PERFORATED PIPE (size) (material)
- (6) pump 1 1/2 20 (HP) (yield gpm)  
ELEC (type power)
- (7) electric log YES (yes or no)  
U.S.G.S. (organization running log)
- (8) how well bottom plugged BACK PRESSURE VALVE

| description of formations encountered | from to |      |
|---------------------------------------|---------|------|
|                                       | feet    | feet |
| CLAY                                  | -0-     | 22   |
| RED Sand                              | 22      | 74   |
| Gravel                                | 74      | 100  |
| Shale                                 | 100     | 130  |
| Sand                                  | 130     | 147  |
| Shale                                 | 147     | 262  |
| green sand                            | 262     | 278  |
| green shale w/ROCKs.                  | 278     | 350  |
| green Sand w/ROCKs.                   | 350     | 409  |
| Shale                                 | 409     | 441  |
| green sand w/ROCKS                    | 441     | 460  |
| green shale                           | 460     | 480  |
| green Sand                            | 480     | 522  |
| green shale + GUMBO                   | 522     | 535  |

CODED

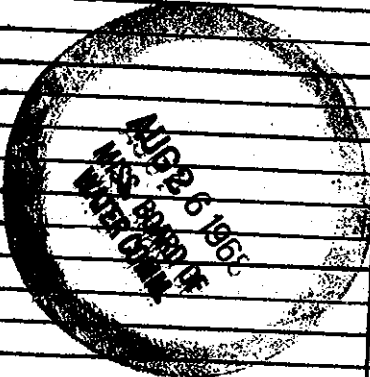

DRILLERS REMARKS: 15L 2 1/2" TAIL PIPE ON BOTTOM OF WELL.