

CARROLL
E 14
7-30-68

MISSISSIPPI
BOARD OF WATER COMMISSIONERS
416 North State Street
Jackson, Mississippi 39201

CODED


WATER WELL DRILLERS LOG

7-30-1968 date well completed
Mrs Roy Armstrong Carroll firm name
CARROLL county well located

LANDOWNER:	description of formations encountered	from	to
MRS ROY ARMSTRONG CARROLL MISS. (mailing address)			
WELL LOCATION: sec. 22 T 19 N R 3 E (distance) miles (direction) of (nearest town)	SAND	35	90
	CLAY SHALE	90	125
	SAND	105	182
	CLAY	182	241
	SHALE ROCK ST.	241	284
	GREEN SAND	284	307
	ROCK	307	308
WELL PURPOSE: Home (home, irrigation, municipal, industrial)	SANDY SHALE	308	340

- WELL COMPLETION DATA:
- (1) diameter (inches) 2"
 - (2) total depth (feet) 308'
 - (3) static water level (feet) 124' below top of ground.
 - (4) casing CAST IRON (material) 298' (depth)
 - 2" (size) if telescope see back.
 - (5) screen 10' (length) 298' (depth to top)
 - 2" (size) STAINLESS (material)
 - (6) pump 1 (HP) 12 (yield gpm)
 - ELEC (type power)
 - (7) electric log NO (yes or no)
 - (organization running log)
 - (8) how well bottom plugged VAUC

CODED

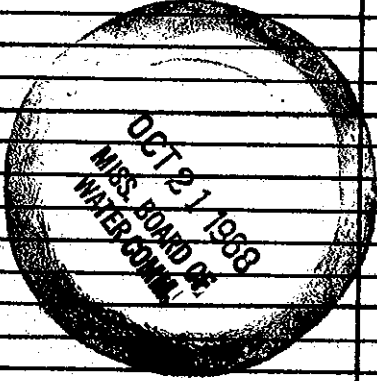

DRILLERS REMARKS: