

CARROLL
E 25
10-14-60

MISSISSIPPI BOARD OF WATER COMMISSIONERS

WATER WELL DRILLERS LOG

CODED

Carroll

Date: OCT 14, 1960, Driller: DELTA DRILLING Co. County: SEFFORE

(Name)

(1) Owner of Land: J.W. SHACKLEFORD
(Name)
CARROLLTON, MISS.
(Address)

(2) Location: 1/4, 1/4, Sec. 27 A.R.3
_____ miles _____ of _____
(distance) (direction) (Nearest Town)

(3) Topography: _____
(Hilly) (Flat) (Level)

(4) Purpose of Well: DOMESTIC
(Domestic Irrigation
Municipal, Industrial, Other)

Description & Color of Materials Sand, Clay, Red Clay, Shell, etc.	Thick- ness Feet	Depth Feet
CLAY	24	24
RED SAND	18	42
GRAVEL	38	80
SAND	123	203
GUMBO w/10" rock	26	229
GREEN SAND w/7" rock	21	250
SHALE	10	260
GREEN SAND w/10" Rock	80	340
SHALE	12	352
SHALE STREAKED SAND	18	370
GREEN SAND w/3" rock	14	384
GREEN SAND -	30	414

Information upon completion of well:

(1) Diameter 4 inches.

(2) Total Depth 414 feet.

(3) Water Level 113 feet below top of ground.

(4) Cased to 414, Size _____

(5) Screen: Size 2, Length 10


(6) Were any formations sealed against pollution?
_____ yes, _____ no.

If YES depth of formation _____

Why _____

Drillers Remarks: 3/4 H.P. RED JACKET
SUBMERSIBLE PUMP SET
IN WELL

CODED

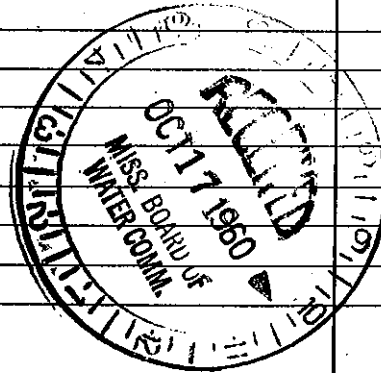

(Use Back Side)

Well No.

Mail this copy to Board of Water Commissioners 429 Miss. St. Jackson. Miss.