

CARROLL MISSISSIPPI BOARD OF WATER COMMISSIONERS

E26

11-21-60

WATER WELL DRILLERS LOG

**CODED** E 300

Date: 11-21, 1960, Driller: BUTANE GAS CO. of COVINGTON County CARROLL LETITIA

(Name)


(1) Owner of Land: <u>ROBERT CARPENTER</u> (Name)	Description & Color of Materials Sand, Clay, Red Clay, Shell, etc.	Thick- ness Feet	Depth Feet
<u>R.R. 3 CARROLLTON, MISS</u> (Address)	<u>RED CLAY</u>	<u>60</u>	<u>60</u>
(2) Location: <u>1/4</u> , <u>1/4</u> , Sec. <u>23</u> T <u>19</u> R <u>3</u>	<u>RED SAND</u>	<u>100</u>	<u>120</u>
<u>3</u> miles <u>WEST</u> of <u>CARROLLTON</u> (distance) (direction) (Nearest Town)	<u>CLAY (BLACK)</u>	<u>20</u>	<u>140</u>
(3) Topography: <u>HILLY</u> (Hilly) (Flat) (Level)	<u>CLAY (BLUE)</u>	<u>10</u>	<u>150</u>
(4) Purpose of Well: <u>DOMESTIC</u> (Domestic Irrigation, Municipal, Industrial, Other)	<u>ROCK</u>	<u>3"</u>	<u>150-3</u>
	<u>CLAY BLUE</u>	<u>499</u>	<u>200</u>
	<u>SAND &amp; SHALE (BR)</u>	<u>50</u>	<u>250</u>
	<u>SAND WHITE</u>	<u>50</u>	<u>300</u>

Information upon completion of well:

- (1) Diameter 2 inches.
- (2) Total Depth 293 feet.
- (3) Water Level 170 feet below top of ground.
- (4) Cased to 273', Size 2"
- (5) Screen: Size 24, Length 20'
- (6) Were any formations sealed against pollution?  
 yes,  no.

If YES depth of formation \_\_\_\_\_  
 Why \_\_\_\_\_  
 Drillers Remarks: \_\_\_\_\_

**CODED**

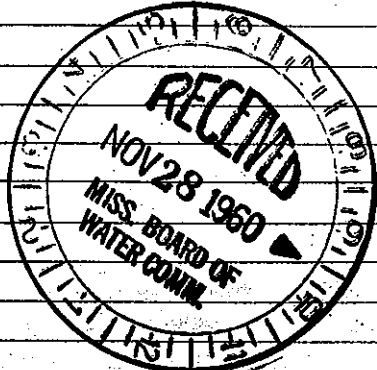

Well No.

(Use Back Side)