

CARROLL MISSISSIPPI BOARD OF WATER COMMISSIONERS

E 27

11-1-62

WATER WELL DRILLERS LOG

Date: NOV. 1, 1962, Driller: DELTA DRILLING Co. County CARROLL


(Name)

(1) Owner of Land:	Description & Color of Materials Sand, Clay, Red Clay, Shell, etc.	Thick- ness Feet	Depth Feet
<u>ELY WILTSHIRE</u> <u>MISS JUNE WILTSHIRE</u> (Name)	CLAY	22	22
<u>CARROLLTON, MISS</u> (Address)	SAND	45	67
(2) Location: <u>NE 1/4, SE 1/4, Sec 14 T14R3E</u>	CLAY	62	129
_____ miles _____ of _____	SHALE	21	150
(distance) (direction) (Nearest Town)	HARD CLAY	22	172
(3) Topography: _____	SHALE W/ROCK	44	216
(Hilly) (Flat) (Level)	GREEN SAND W/ROCK	64	280
(4) Purpose of Well: <u>DAMESTIC</u>	SHALE	22	302
(Domestic Irrigation Municipal, Industrial, Other)	GREEN SAND	48	350

Information upon completion of well:

- (1) Diameter 2 inches.
- (2) Total Depth 350 feet.
- (3) Water Level _____ feet below top of ground.
- (4) Cased to 330, Size 2"
- (5) Screen: Size 24', Length 20'
PERFORATED PIPE-
- (6) Were any formations sealed against pollution?
_____ yes, _____ no.

CODED

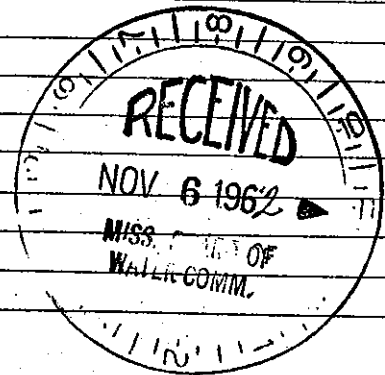

Drillers Remarks: 1/2 H.P. "MONOTOR"
6" STROKE PUMP W/42 GAL-TANK
INSTALLED WITH 1-1/8" WOOD
ROD-

Well No.

(Use Back Side)

Mail this copy to Board of Water Commissioners 429 Miss. St. Jackson, Miss.