

CARROLL MISSISSIPPI BOARD OF WATER COMMISSIONERS

E28

7-30-64

WATER WELL DRILLERS LOG

CODED

CARROLL

Date: July 30, 1964, Driller: Robert E. Raliff County: Carroll
(Name)

(1) Owner of Land: Sam (Mye) AYERS
(Name)
Carrollton, Miss
(Address)

(2) Location: 1/4, 1/4, Sec. 12 19 R3,
2 miles North of N. Carrollton
(distance) (direction) (Nearest Town)

(3) Topography: Hilly
(Hilly) (Flat) (Level)

(4) Purpose of Well: Domestic
(Domestic Irrigation Municipal, Industrial, Other)

Description & Color of Materials Sand, Clay, Red Clay, Shell, etc.	Thick- ness Feet	Depth Feet
Clay & sand	0	03
hard clay	03	46
gravel	46	62
shale	62	69
hard shale	69	190
shale	190	212
hard shale	212	234
hard shale	234	299
shale	299	321
shale	321	343
hard shale	343	365
sand	365	462

Information upon completion of well:

(1) Diameter 2 inches.

(2) Total Depth 462 feet.

(3) Water Level 34 feet below top of ground.

(4) Cased to 462, Size 2

(5) Screen: Size 2", Length 5'


(6) Were any formations sealed against pollution?
 yes, no.

If YES depth of formation Cased

Why _____

Drillers Remarks: _____

CODED

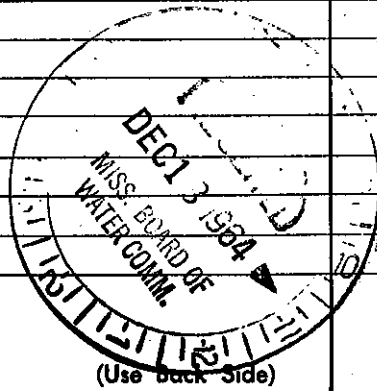

Well No. _____

Mail this copy to Board of Water Commissioners 429 Miss. St. Jackson, Miss.