

CARROLL
E 29
11-29-65

WATER WELL DRILLERS LOG **CODED**

Date: NOV. 29, 1965, Driller: DELTA DRILLING Co. County CARROLL
(Name)

(1) Owner of Land: LINZY WATERS
(Name)

(2) Location: 25 19-3
1/4, 1/4, Sec. T R

_____ miles _____ of _____
(distance) (direction) (Nearest Town)

(3) Topography: _____
(Hilly) (Flat) (Level)

(4) Purpose of Well: DOMESTIC
(Domestic Irrigation
Municipal, Industrial, Other)

Description & Color of Materials Sand, Clay, Red Clay, Shell, etc.	Thick- ness Feet	Depth Feet
CLAY	46	46
Sand	41	87
Clay	112	199
Shale	18	217
CLAY	20	237
Shale W/ROCKS	21	258
Sand	78	336

Information upon completion of well:

(1) Diameter 4 inches.

(2) Total Depth 336 feet.

(3) Water Level _____ feet below top of ground.

(4) Cased to _____, Size 2 7/8" 4 1/2"

(5) Screen: Size 2", Length 20'
PERFORATED PIPE


(6) Were any formations sealed against pollution?
_____ yes, _____ no.

If YES depth of formation _____

Why _____

Drillers Remarks: _____

CODED

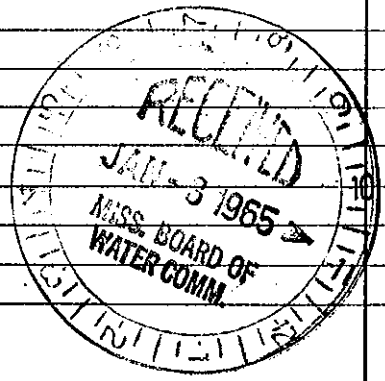

(Use Back Side)

Well No.

Mail this copy to Board of Water Commissioners 429 Miss. St. Jackson, Miss