

**CARROLL MISSISSIPPI BOARD OF WATER COMMISSIONERS**

**E 39**

**2-13-64**

**WATER WELL DRILLERS LOG CODED**

Date: FEB 13, 1964, Driller: DELTA DRILLING Co. County: CARROLL

(Name)

(1) Owner of Land: <u>W. H. MOORE</u> (Name)	Description & Color of Materials Sand, Clay, Red Clay, Shell, etc.	Thick- ness Feet	Depth Feet
<u>RTE 3, CARROLLTON, MISS</u> (Address)	<u>CLAY</u>	<u>44</u>	<u>44</u>
	<u>SAND</u>	<u>180</u>	<u>154</u>
(2) Location: <u>SE 1/4, SE 1/4, Sec. 16 T29R3W</u>	<u>SHALE</u>	<u>20</u>	<u>174</u>
	<u>GUMBO</u>	<u>43</u>	<u>217</u>
_____ miles _____ of _____ (distance) (direction) (Nearest Town)	<u>SHALE W/ROCKS</u>	<u>52</u>	<u>269</u>
(3) Topography: _____ (Hilly) (Flat) (Level)	<u>SAND</u>	<u>30</u>	<u>299</u>
	<u>SHALE</u>	<u>30</u>	<u>329</u>
(4) Purpose of Well: <u>DOMESTIC</u> (Domestic Irrigation Municipal, Industrial, Other)	<u>SAND</u>	<u>18</u>	<u>347</u>
	<u>SHALE</u>	<u>13</u>	<u>360</u>
	<u>SAND</u>	<u>24</u>	<u>384</u>

Information upon completion of well:

- (1) Diameter 4 inches.
- (2) Total Depth 384 feet.
- (3) Water Level 150 feet below top of ground.
- (4) Cased to 359, Size 250'-4"  
109'-2"
- (5) Screen: Size 2", Length 25'  
2" PERFORATED PIPE
- (6) Were any formations sealed against pollution?  
\_\_\_\_\_ yes, \_\_\_\_\_ no.


If YES depth of formation \_\_\_\_\_

Why \_\_\_\_\_

Drillers Remarks: RED JACKET

SUBMERSIBLE PUMP SET

168' IN WELL

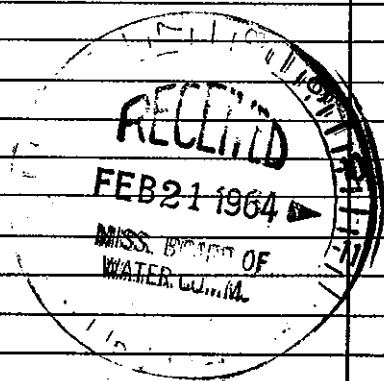

Well No.

(Use Back Side)

Mail this copy to Board of Water Commissioners 429 Miss. St. Jackson, Miss.