

CARROLL MISSISSIPPI BOARD OF WATER COMMISSIONERS


E41

10-65

WATER WELL DRILLERS LOG CODED

Date: Oct, 1965, Driller: Jack Martin County Holmes
(Name)

(1) Owner of Land: <u>Floyd Ray</u> (Name)	Description & Color of Materials Sand, Clay, Red Clay, Shell, etc.	Thick- ness Feet	Depth Feet
<u>Carrollton</u> (Address)	clay	17	17
(2) Location: <u>NW 1/4, NE 1/4, Sec 21 T19R35E</u>	pipe clay	15	32
<u>3</u> miles <u>West</u> , of <u>Carrollton</u> (distance) (direction) (Nearest Town)	pipe clay-sand	9	41
(3) Topography: <u>Hilly</u> (Hilly) (Flat) (Level)	bravel sand	44	85
(4) Purpose of Well: <u>Domestic</u> (Domestic Irrigation Municipal, Industrial, Other)	Sand	46	131
Information upon completion of well:	Sand-mud streaks	9	140
(1) Diameter <u>4</u> inches.	Sand	58	198
(2) Total Depth <u>614</u> feet.	Mud	57	255
(3) Water Level _____ feet below top of ground.	Green sand	51	306
(4) Cased to _____, Size _____.	Mud	88	394
(5) Screen: Size _____, Length _____.	Sand-mud	22	416
(6) Were any formations sealed against pollution? _____yes, _____no.	Mud	12	428
If YES depth of formation _____	Mud + sand	112	540
Why _____	Sand	14	554
Drillers Remarks: _____	Mud	10	564
_____	Sand	5	569
_____	Mud	7	576
_____	Sand	38	614
_____	Rock layers at		
_____	236 - 247 - 306 -		
_____	428 - 434 - 435 -		

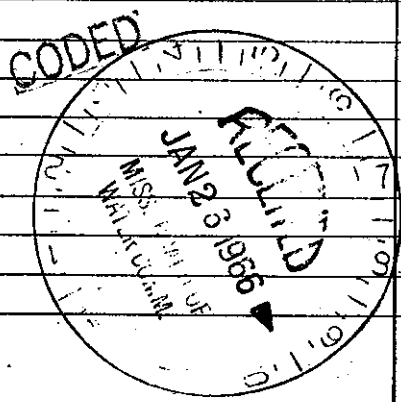

(Use Back Side)

Well No.

Mail this copy to Board of Water Commissioners 429 Miss. St. Jackson, Miss.